


Section 14 Township 29 Range 5E

Well No. #1 Naden

Company H. H. Blair

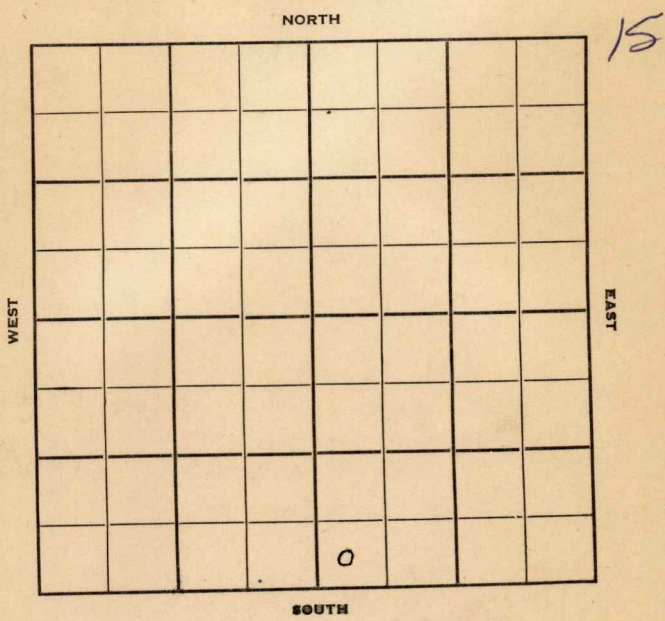

Sec. 14 Twp. 29 R. 5E ✓

Well No. #1 Naden Farm

H. H. Blair Company

Watson - Contr. Contractor


Ft. from N. Line

330' Ft. from S. Line

Ft. from E. Line

330' Ft. from W. Line

SW SW SE

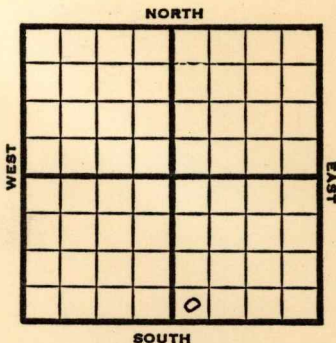

1951 **Elev. 1344'** REPORT

8/8 Spud 7-30-51
8" @ 85
Drlg. 2330'

9/5 Spud 7-30-51
Oil Well TD 2813
8" @ 85
KC 2176 Bart. 2773
Cored 2780-90 rec. 5' shly sd.
5' sdy sh.
Cored 2790-2801 rec. 4' sdy sh.
7' mud grained sand w/ SO
Cored 2801-13 rec. 8' sd. w/ SO
TD 2813
5" @ 2796 CO to 2811 B/ 5 bopd
48/ 2797-2809 Hydrofrac
F/ 11 bo 2 hr. S/ 6 boph
Comp. 33 bopd

COMPLETED

Operator H. H. Blair

Well No. 1 Farm Naden

[illegible]

FIRST REPORT

330 Ft. From S Line SE

330 Ft. From Line Quarter

1st. Report AUG 8 1951

Completion

Remarks

Watson - Contr.

Spudding Date 7-30-51

Drlg. Data

8" @ 85 drlg. 2330

J. E. TYRA

