


Ellis

KANSAS

SECTION 14 TOWNSHIP 14 RANGE 20W

WELL NO. #1 Cerney

COMPANY K&E Drlg.

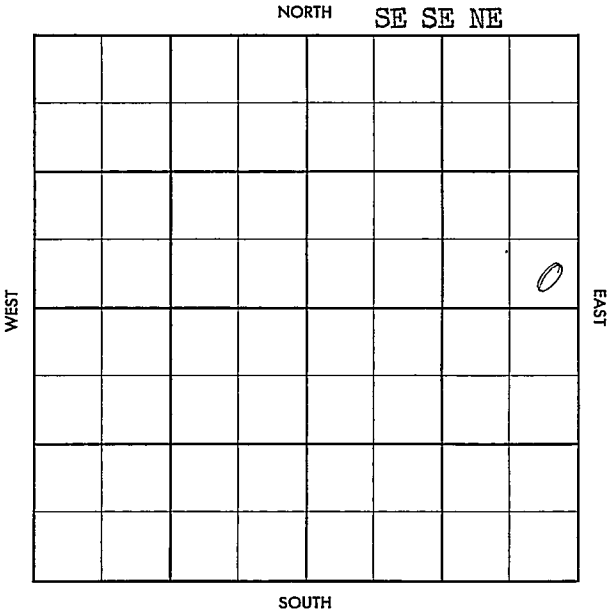

WILDCAT

FORM 513 SUNRAY

County Ellis Elev. 2158 DF

Sec. 14 Twp. 14 Rge. 20W

Company K & E Drilg.

FarmName Cerney No. 1

TOPS	DEPTH	LOG	DATUM
------	-------	-----	-------

Anh.			
Tp.			
H.			
Tr.			
Dg.			
Bl.			
L.			
K.C.			
B.K.C.			
Ce.			
C.			
M.			
M.			
K.			
Mz.			
Ma.			
V.			
S.			
S.			
A.			
R.			
PE.			
G.			
T.D.			

Loc. in Sec. _____

SE SE NE

Geol. _____

Contr. _____

Co. Tools _____

Pool PLEASANT

Wildcat

PR 24/57

FIRST REPORT

Date Comm. _____

Location _____

Co.

Sec.

No.

Sec.

1.

R.

Pleasant Field

FORM 518 SUNRAY

Co.

Sec.

No.

Sec.

T.

R.


County Ellis Elev. 2158 DF
 Sec. 14 Twp. 14 Rge. 20W
 Company K & B Drllc.
 FarmName Cerney No. 1

TOPS	DEPTH	LOG	DATUM
Anh.			
TP.			
H.	3416		
Tr.			
Dg.			
Bl.			
L.	3460		
K.C.			
B.K.C.	3707		
Ce.			
C.	Marm 3752		
M.	cg 3777		
M.			
K.			
Mz.			
Mo.			
V.			
S.			
S.			
A.	3793		
R.			
PE.			
G.			
TD.	383J		

Loc. in Sec. SE SE NE

Geol. _____
 Contr. _____
 Co. Tools _____

Pool Wildcat

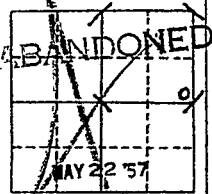

Date Comm. TEX D.H.M.
 Location MAY 1 '57 ✓ MAY 22 '57 5-6-57

8 1/8 230 / 130 WOC MAY 16 57
DST MAY 22 57 DST 3733-80 30"
10' Md BHP 904 DST 3796
-3805 20" 70' Md BHP
1097 / 30" DST 3776-98 20"
5' Md BHP 205 / 30"

D.P.A.