

KANSAS


Form 51-5M-7-39-Palace

McPherson

Section 18 Township 17 Range 1-W

Well No. #3 Henne

Company Westgate Greenland

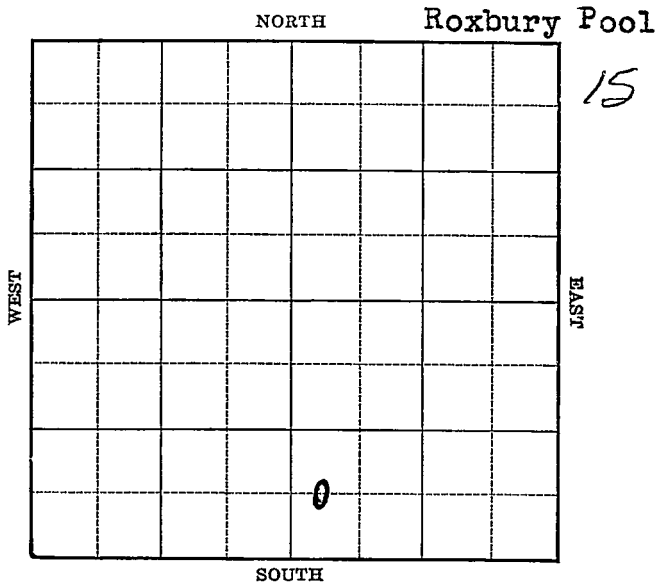

Sec. 18 Twp. 17 R. 1-W

Well No. #3 Henne Farm

Westgate Greenland Company

(Roxbury)


 Ft. from N. Line

660 Ft. from S. Line

 Ft. from E. Line

330 Ft. from W. Line

Elev. 1358

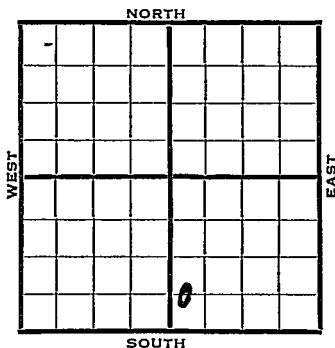

1940.	REPORT
5/29	Location
6/6	"
6/13	"
6/20	"
6/27	"
7/3	"
7/11	"
7/18	R.O.G.
7/25	Derrick.
8/2	Rotary rig.
8/8	" "
8/14	" "
8/22	" "
8/29	Rigging up.
9/5	10" - 148' Drlg. 500'
9/12	Miss. 2653-55' T.D. 5" - 2653'
	RUST.
9/19	"
	OVER

1940
9/25

Miss. 2653'

5" - 2653'

T.D. 2675'

1500 acid.

Potential 705 bbls., pump.

COMPLETED

Map No. 42 Sec. 18 Twp. 17 R. 1W

Well No. 3 Henne

Westgate Greenland Company

Contractor

FIRST REPORT

SECTION PLAT

C W L SW SE

		o	1

_____ Ft. from N. Line

660 Ft. from S. Line

_____ Ft. from E. Line

330 Ft. from W. Line

ROXBURY POOL

Location X

Rig up _____

Drilling and Remarks:

RECORD

Cased _____ in., _____ ft.

Sand _____

Gas _____

Oil _____

Total Depth _____

PRODUCTION

1st 24 hrs. Nat. _____

1st 24 hrs. after shot _____

Gas _____ Cu. Ft.

Dry Hole _____

Abandoned _____

Date

MAY 29 1940 19

S. J. LEWIS Scout

Map No. 42 Sec. 18 Twp. 17 R. 1W

Well No. 3 Henne

Westgate Greenland

Company

Contractor

COMPLETED

C W L SW SE

_____ Ft. from N. Line

660 Ft. from S. Line

_____ Ft. from E. Line

330 Ft. from W. Line

ROXBURY POOL

SECTION PLAT

Location _____

Rig up _____

Drilling and Remarks:

Mcs 2653
5" @ 2653
1500 cu ft
Pump 705 Pk.

RECORD

Cased _____ in., _____ ft.

Sand _____

Gas _____

Oil _____

Total Depth 2675

PRODUCTION

1st 24 hrs. Nat. _____

1st 24 hrs. after shot _____

Gas _____ Cu. Ft.

Dry Hole _____

Abandoned _____

Date

SFP 25 1940 19

S. J. LEWIS Scout