

Ellis


KANSAS

SECTION 14 TOWNSHIP 14 RANGE 20W

WELL NO. #1 Cerney

COMPANY Thunderbird Drlg.

NORTH

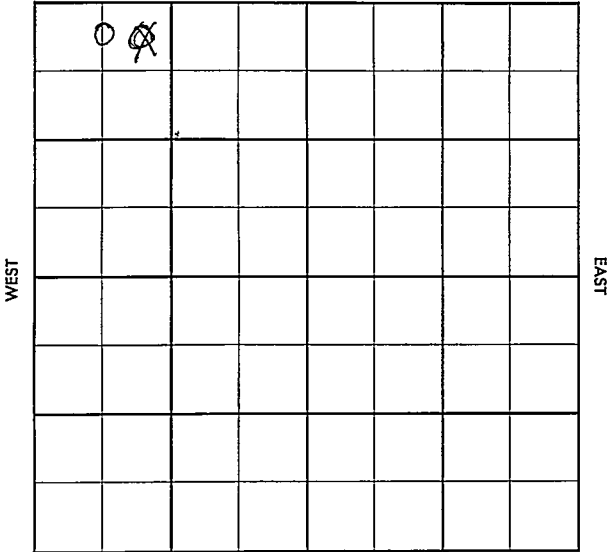

SOUTH

# WILDCAT

FORM 513 SUNRAY

County Ellis Elev. \_\_\_\_\_  
 Sec. 14 Twp. 14 Rge. 20W  
 Company Thunderbird Drlg.  
 Farm Name Cerney No. 1

TOPS	DEPTH	LOG	DATUM
Anh.			
Tp.			
H.			
Tr.			
Dg.			
Bl.			
L.			
K.C.			
B.K.C.			
Ce.			
C.			
M.			
M.			
K.			
Mz.			
Mo.			
V.			
S.			
S.			
A.			
R.			
PE.			
G.			
T.D.			

Loc. in Sec. NE NW NW

Geol. \_\_\_\_\_  
 Cont. \_\_\_\_\_  
 Co. Tools \_\_\_\_\_  
 Pool Pleasant  
Wildcat

FIRST REPORT

DEC 19 1936

Date Comm. \_\_\_\_\_

RURT

~~14~~

Co.

No.

No.

Sec.

T.

R.

# CORRECTION

FORM 513 SUNRAY

County ELLIS Elev. 2149  
 Sec. 14 Twp. 14 Rge. 20E  
 Company WILLIAMSON OIL CO. LP  
 No. 1

	LOG	DATUM	Loc. in Sec.
Tr.	3421	3422	N2
Dg.		3434	
L.	3441	3440	
B.K.C.		3686	
Ce. <u>Marin</u>		3735	
C. <u>SB</u>	3769	3766	Co. <u>Pools</u>
M. <u>CG SD</u>	3797		Pool <u>Pleasant</u>
K.			W. <u>Great</u>
Mz.			
Ma.			
V.			
S.			
S.			
A.			
R. <u>SD</u>		3799	<b>ABANDONED</b>
PE.		3837	
G.			
TD.	3840		JAN 9 '57

Date Comm. RURT DEC 25 56 12-17-56 P 78  
298/150 @ 2970 JAN 2 '57 X  
DST 3800-15  
are 285' SW BHP 450' 120"  
FP 60-180  
DEA