

KANSAS


FORM 51 5M 11-44 PETROL

Ellis County

Section 11 Township 14 Range 20W

Well No. #3 Josephine

Company Sunray

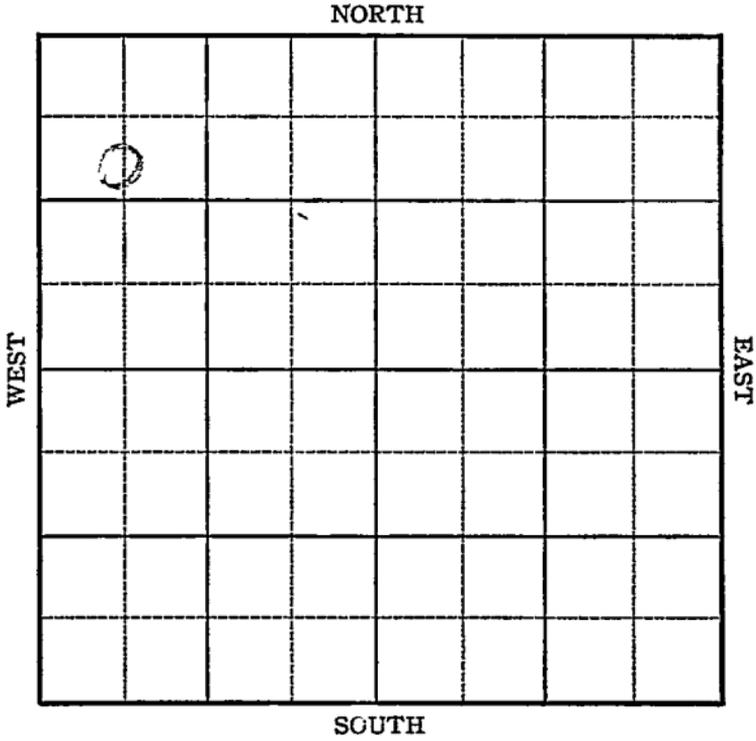

Sec. 11 Twp. 14 R. 20W

Well No. #3 Josephine Farm

Sunray Company


Pleasant

990 Ft. from N. Line

_____ Ft. from S. Line

_____ Ft. from E. Line

660 Ft. from W. Line

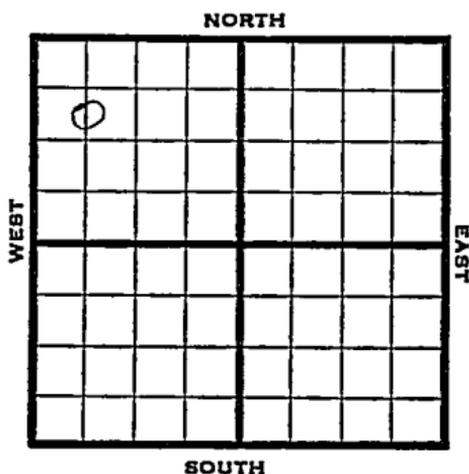

CSL NW NW

1946	Elev. 2230'	REPORT
------	-------------	--------

2/13	SH
2/21	Anhy 1518' 8" - 1526' Drlg. 2790'
2/28	Lans. 3524' B.K.C. 3748' Cong. 3813' Arb. 3832-35' T.D. 5" - 3833' RUST.
3/7	T.D. 3844' Swab 18 oil 23 hours.
3/13	Arb. 3832 5" @ 3833 1000 acid. TD 3844' Pump 30 Pot. Grav. 33.0

COMPLETED

KANSAS Kansas Pool Name Pleasant

Map No. 70 Sec. 11 Twp. 14 R. 20W.

Well No. 3 Josephine

Sunray Company

FIRST REPORT Contractor

C S L NW NW

SECTION FLAT

990 Ft. from N. Line

_____ Ft. from S. Line

_____ Ft. from E. Line

660 Ft. from W. Line

o			

Ellis County

Location _____

Rig up _____

Drilling and Remarks:

SH

RECORD

Cased _____ in., _____ ft.

Sand _____

Gas _____

Oil _____

Total Depth _____

PRODUCTION

1st 24 hrs. Nat. _____

1st 24 hrs. after shot _____

Gas _____ Cu. Ft.

Dry Hole _____

Abandoned _____

Date

B 1 3 1946 19

S. J. LEWIS Scout

Pool Name Pleasant

KANSAS Kansas

Map No. 70 Sec. 11 Twp. 14 R. 20W

Well No. 3 Josephine

Sunray Company

COMPLETED

Contractor

C S L NW NW

E 1, 2 2 80
SECTION PLAT

0			

990 Ft. from N. Line

 Ft. from S. Line

 Ft. from E. Line

660 Ft. from W. Line

Ellis County

Location _____

Rig up _____

Drilling and Remarks:

Cr 3832
5" @ 3833
1000 acid
Pump 30 ft.
33 @ 38

RECORD

Cased _____ in, _____ ft.

Sand _____

Gas _____

Oil _____

Total Depth 3844

PRODUCTION

1st 24 hrs. Nat. _____

1st 24 hrs. after shot _____

Gas _____ Cu. Ft.

Dry Hole _____

Abandoned _____

Date

MAR 13 1946 19

S. J. LEWIS Scout