


Section 15 Township 29 Range 5E

Well No. 2 Barry

Company Rex & Morris & CRA

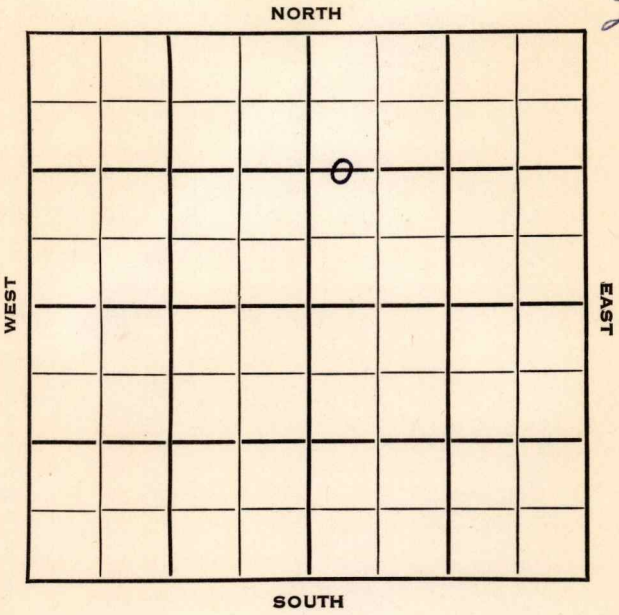

SEC.	TWP.	R.
15	29	5E

WELL NO. \_\_\_\_\_

COMPANY #2 Barry FARM

CONTRACTOR Rex & Morris & CRA

**Fox Bush Pool**

1320 \_\_\_\_\_ Ft. from N. Line

\_\_\_\_\_ Ft. from S. Line

\_\_\_\_\_ Ft. from E. Line

330 \_\_\_\_\_ Ft. from W. Line

W<sup>1</sup>/<sub>2</sub> W<sup>1</sup>/<sub>2</sub> NE

1954	ELEVATION	REPORT
	Elev. -	

1/6 Spud 1-2-54  
8" @ 97'  
Drlg 635'

1/13 Spud 1-2-54  
8" @ 97'  
**Miss 2845'**  
TD 2880'  
D&A

**ABANDONED**



