


Section 14 Township 14 Range 20W

Well No. #1 Gerney *(Gerney)*

Company Lindas Oil

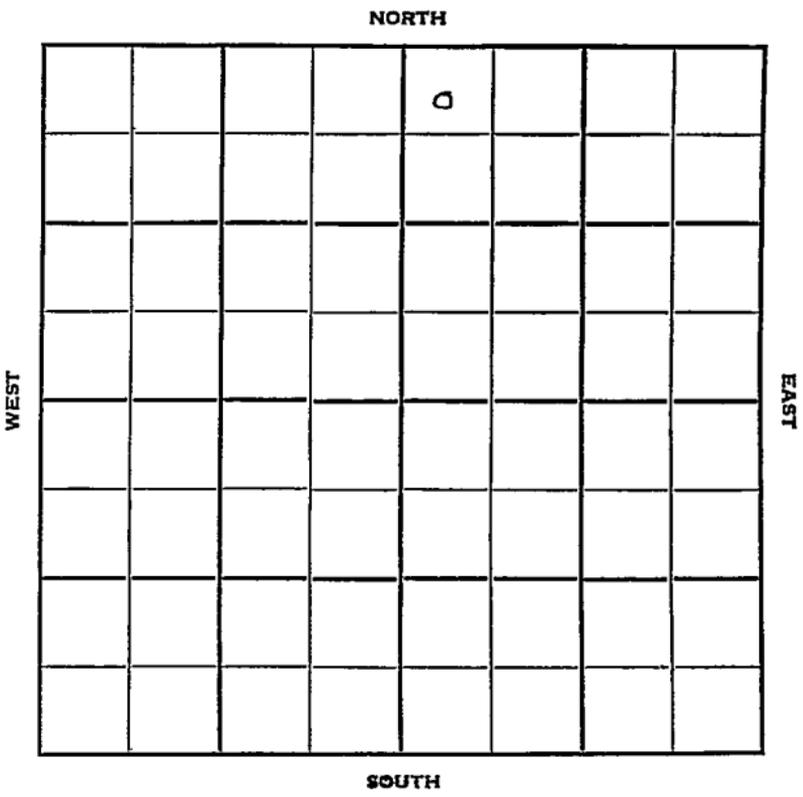

Sec. 14 Twp. 14 R. 20W

Well No. #1 Cerney Farm

Lindas Oil Company

Contractor

Semi-Wildcat


330' Ft. from N. Line

_____ Ft. from S. Line

_____ Ft. from E. Line

330' Ft. from W. Line

NW NW NE

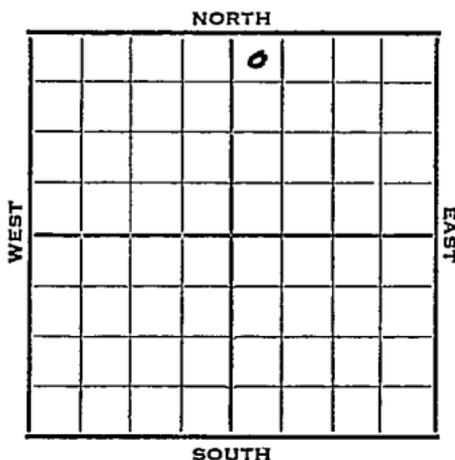

1952 Elev. 2209' REPORT

6/4 Spud 5-30-52
8" @ 202
Anhy 1495
Drlg. 2415

6/11 Heeb 3457' Tor 3481' Lans. 3501'
Arb. 3840'
DST 3840-45, 1/2 hr, 5' M

6/18 Spud 5-30-52
D&A TD 3894' 8" @ 202'
Anhy 1495 Heeb. 3452
Tor. 3481 Lans. 3496
DST 3817-26 open 1/2 hr. rec. 5' mud
Arb. 3834
DST 3840-45 open 1/2 hr. rec. 5' mud
DST 3817-57 open 1 hr. rec. 95' wcm
DST 3845-57 failed Reagan 3882
TD 3894 D&A

ABANDONED


County Ellis State Kansas

Sec. 14 (Blk. Twp.) 14 (Sur. Rge.) 20W Map No.

Operator Lindas Oil

Well No. 1 Farm Corney

Elev. Location NW NW NE

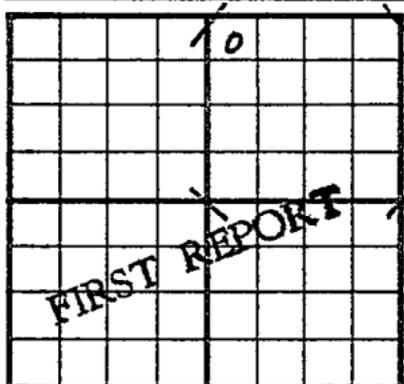

330 Ft. From N Line NE

330 Ft. From W Line Quarter

Ist. Report JUN 4 1952

Completion

Remarks Skiles & Phillips support

Spudding Date 5-30-52

Drlg. Data Semi Wildcat

8" @ 202 Anhy 1495 drlg. 2415


County Ellis State Kansas

Sec. 14 (^{Bk.}Twp.) 14 (^{Sur.}Rge.) 20W Map No.

Operator Lindas Oil

Well No. 1 Farm Cerney

Elev. 2209 Location NW NW NE

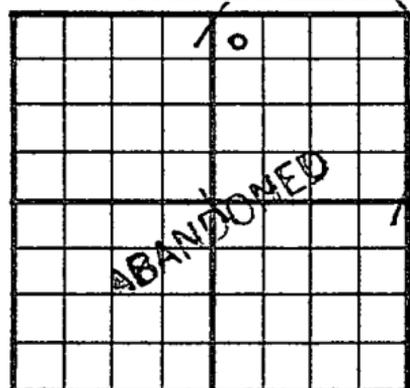

330 Ft. From N Line NE

330 Ft. From W Line Quarter

Ist. Report

Completion JUN. 18 1952

Remarks Semi Wildcat

Spudding Date 5-30-52

Drlg. Data D & A TD 3894

8" @ 202 Anhy 1495 Heeb. 3452

Tor. 3481 Lans. 3496 DST 3817-26

open 1/2 hr. Rec. 5' mud Arb. 3854

DST 3840-45 open 1/2 hr. Rec. 5' mud

DST 3817-57 open 1 hr. Rec. 95' wcm

DST 3845-57 failed Reagan 3882

TD 3894 D & A

J. G. McGEHEE