

Butler

KANSAS

Sec. 15 Twp. 29 R. 5 E

Well No. # 1 Perry Farm

K. T. Weidemann Company

Contractor

Wildcat


330 Ft. from N. Line

Ft. from S. Line

Ft. from E. Line

330 Ft. from W. Line

NW NW NE

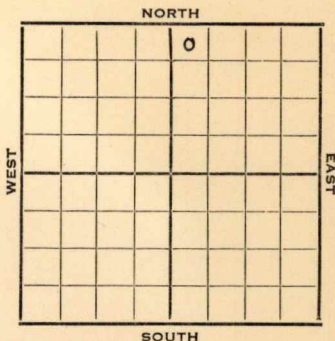

1951	Elev. 1355' REPORT
11/21	Spud 11-13-51 8" @ 85' KC 2223' B KC 2457' Drlg. 2475'
1952 1/9	Spud 11-13-51 D&A TD 2879 8" @ 85' KC 2223 B KC 2457 Miss 2857 7" @ 2862 TD 2879 HFW D&A
ABANDONED	

County **Butler** State **Kansas**

Sec. **15** (Blk. Twp.) **29** (Sur. Rge.) **5E** Map No.

Operator **K. T. Weidemann**

Well No. **1** Farm **Perry**

Elev. Location **NW NW NE**

FIRST REPORT

330 Ft. From **N** Line **NE**

330 Ft. From **W** Line Quarter

Ist. Report **NOV 21 1951**

Completion

Remarks

Spudding Date **11-13-51**

Drlg. Data **Wildcat**

8" @ 85 KC 2223 B KC 2457 drlg. 2475

County Butler State Kansas

Sec. 15 (Blk. 29) (Sur. 5E) Map No.

Operator K. T. Weidemann

Well No. 1 Farm Perry

Elev. 1355 Location NW NW NE

		o		

330 Ft. From N Line NE

330 Ft. From W Line Quarter

1st. Report

Completion JAN 9 1952

Remarks Wildcat

Spudding Date 11-13-51

Drlg. Data D & A TD 2879

8" @ 85 KC 2223 B KC 2457 Miss. 2857

7" @ 2862 TD 2879 HFW

D & A

J. E. TYRA