


Section 15 Township 29 Range 5E

Well No. #1 Young

Company Rex & Morris

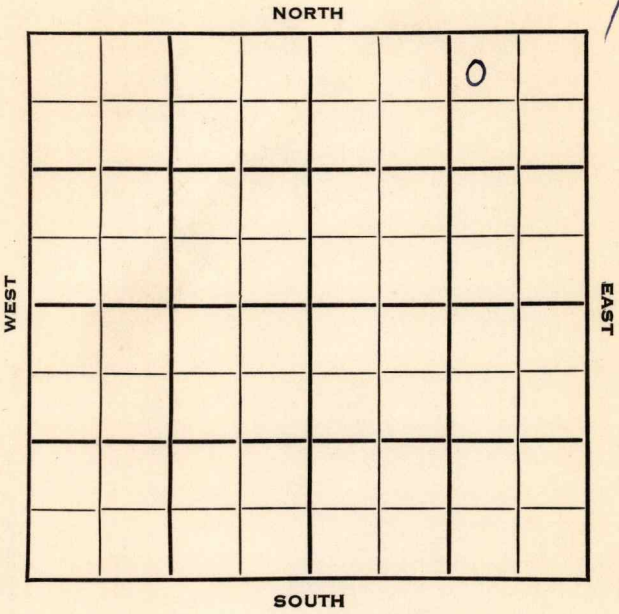


SEC.	15	TWP.	29	R.	5E
------	----	------	----	----	----

WELL NO. #1 Young FARM

COMPANY Rex & Morris

CONTRACTOR Rex & Morris

Wildcat  
 330 Ft. from N. Line  
 Ft. from S. Line  
 990 Ft. from E. Line  
 Ft. from W. Line

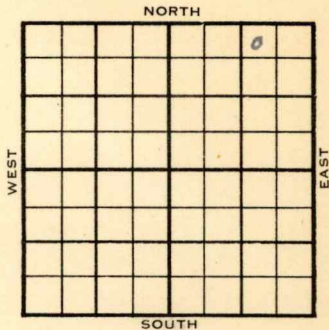

NW NE NE

1953	ELEVATION 1345'	REPORT
------	--------------------	--------

10/7

Location

11/4

Spud 10-17-53  
 Oil Well  
 TD 2848'  
 8" @ 107'  
 KC 2204', B KC 2432', Bart 2837'  
 TD 2843  
 5" @ 2837  
 DD 2848  
 FU 2000' oil 8 hrs.  
 S/31 bo 5 hrs.  
 S/6 bo 1/2 hr.  
 Comp. 30 bopd

**COMPLETED**



