


SECTION 21 TOWNSHIP 14S RANGE 19W

WELL NO. #2 Perry

COMPANY Shields

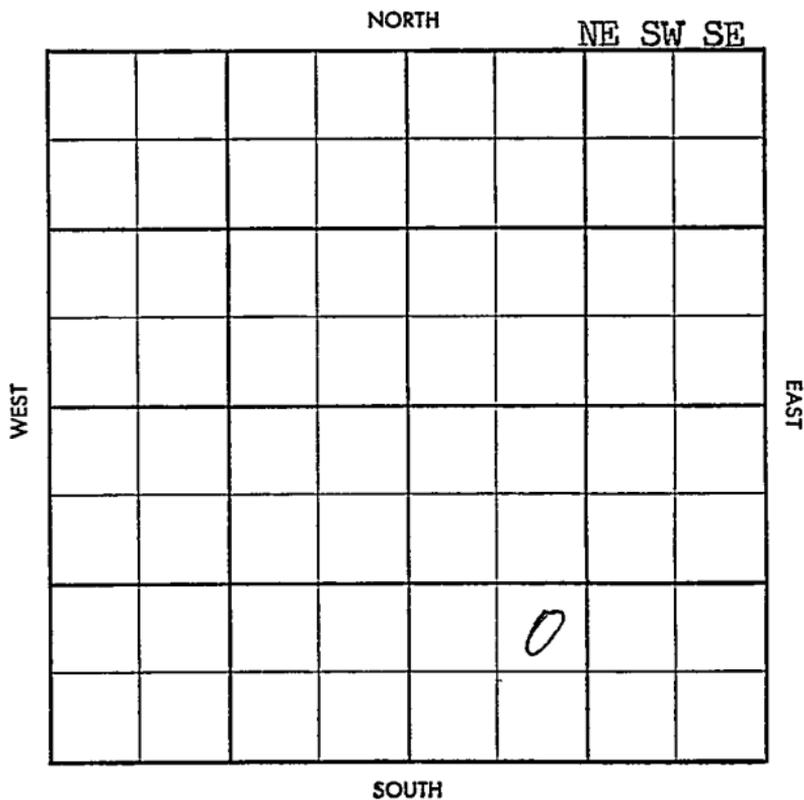

~~KRAUS~~

~~X~~

S-513-A

FIRST REPORT			
OCT	25	0	

CO. Ellis ELEV. \_\_\_\_\_  
 SEC. 21 TWP. 14 RGE. 19W  
 COMPANY Shields NO. 2

FARM Perry  
 LOC. NE SW SE


GEOL. \_\_\_\_\_  
 CONTR. Co. Tools  
 POOL Kraus  
 SPUD \_\_\_\_\_  
MIRT

CO.

LSE.

NO.

SEC.

TWP.

RGE.

~~Kraus~~

S-513-A 1

CO ~~Ellis~~ ELEV. 2197

SEC. 27 TWP. 14 RGE 19W

COMPANY Shields NO 2

COMPLETE

DEC 18 '57

FARM Perry

LOC NE SW SE

An 1462
Ab 3442
TR 3461
KC 3484 2197
Ma 3759 1562
C 3778 1581
Don 3783 1586
A 3809 1612
TD 3811

GEOL.

CONTR Co. Tools

POOL Kraus

SPUD 10-1-57

MIRT 5.1 9 57

85% 280 TD 3426

NOV 15 57 DST 3518-60

60" 70' WM BHP

1120 DST 3653-9

60" 835' GIP 15'

OCM 75' Mly 01175' 899401

BHP 1120 5 2 3810 OCT 20

CO 3811 A 586 BOPH NAT

P 6 P 157 NOV 6 57 NOV 20 57

NOV 27 57 DEC 4 57

PHY P

96 BOPH + 35 90 W

36.20 W

auto open

CO.

LSR

NO.

SEG.

TWP.

RGE.