

Map No. Kansas Sec. 19 Twp. 29 R. 5
 Well No. 1- Sutton Farm
E. B. Shawner Company

NORTH

WEST

EAST

SOUTH

Location _____

Drilling Remarks _____

Rig Up _____

Drilling Remarks _____

RECORD

Cased _____ in. _____ ft.

Sand _____

Gas _____

Oil _____

Total Depth _____

PRODUCTION

1st 24 hrs. Nat. _____

1st 24 hrs. after shot _____

Gas _____ cu. ft.

Dry Hole _____

Abandoned _____

Butler

Map No. Kansas Sec. 19 Twp. 29 R 5


Well No. 1 Sutton Farm
E. B. Shawver Company

NORTH

WEST

EAST

SOUTH

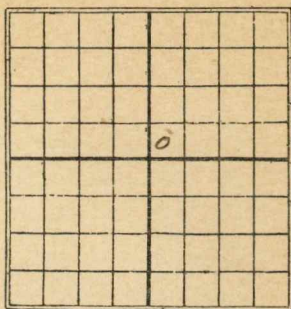

Ft. from N. Line

330 Ft. from S. Line

Ft. from E. Line

330 Ft. from W. Line

Date 1926 REPORT

<u>4/7</u>	<u>Ry up</u>	
<u>4/14</u>	<u>Spudding</u>	
<u>4/21</u>	<u>Drilling</u>	<u>450</u>
<u>4/30</u>	"	<u>1100</u>
<u>5/8</u>	"	<u>1850</u>
<u>5/12</u>	"	<u>2050</u>
<u>5/19</u>	"	<u>2500'</u>
<u>6/2</u>	"	<u>3195'</u>
<u>6/9</u>	<u>O. & A.</u>	<u>3307</u>

Butler
K11 KANSAS Map No. _____ Sec. *19* Twp. *29* R. *5*
 Well No. *Sutton*
B. B. Shawver _____ Company
 _____ Contractor

FIRST REPORTS

SECTION PLAT

_____ Ft. from N. Line

330

_____ Ft. from S. Line

_____ Ft. from E. Line

330

_____ Ft. from W. Line

Location _____

Rig up ☒ _____

Drilling and Remarks:

RECORD

Cased _____ in., _____ ft.

Sand _____

Gas _____

Oil _____

Total Depth _____

PRODUCTION

1st 24 hrs. Nat. _____

1st 24 hrs. after shot _____

Gas _____ Cu. Ft.

Dry Hole _____

Abandoned _____

Date

APR 7 1926

192

CHAS. L. SHERWOOD

Scout

Butler
 K11 KANSAS Sec. 19 Twp. 29 R. 5

Well No. 1 *Sutton*
E. B. Shawver Company

Contractor

COMPLETED

SECTION PLAT

_____ Ft. from N. Line

330 _____ Ft. from S. Line

_____ Ft. from E. Line

330 _____ Ft. from W. Line

ABANDONED

		0	

Location _____

Rig up _____

Drilling and Remarks:

Tap line 2855'
1st Break 2895'

O & A

3307' AFN

RECORD

Cased _____ in., _____ ft.

Sand _____

Gas _____

Oil _____

Total Depth *3307'*

PRODUCTION

1st 24 hrs. Nat. _____

1st 24 hrs. after shot _____

Gas _____ Cu. Ft.

Dry Hole *✓*

Abandoned *✓*

Date

JUN 9 1926

192

CHAS. L. SHERWOOD

Scout