


Section 17 Township 29 Range 5 E

Well No. # 1 Qualls

Company Cappitt Drlg.

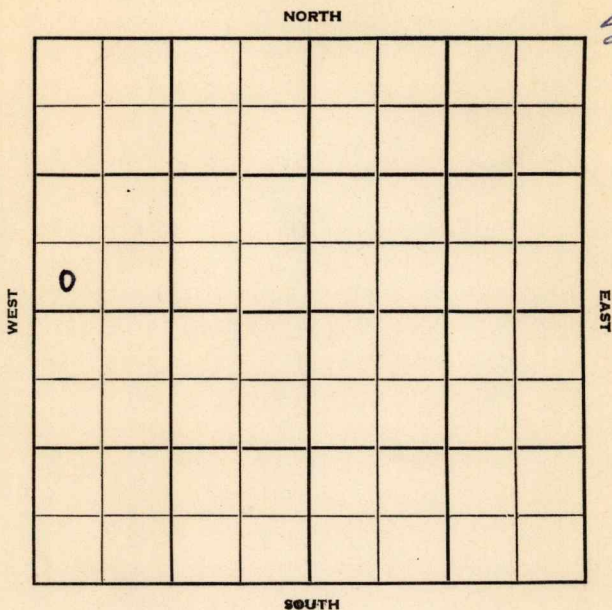

KANSAS ✓

Butler

Sec. 17 Twp. 29 R. 5E

Well No. #1 Qualls Farm

Cappitt Drlg. Company

Cappitt Drlg. - Contr. Contractor


 Ft. from N. Line

330' Ft. from S. Line

 Ft. from E. Line

330' Ft. from W. Line

SW SW NW

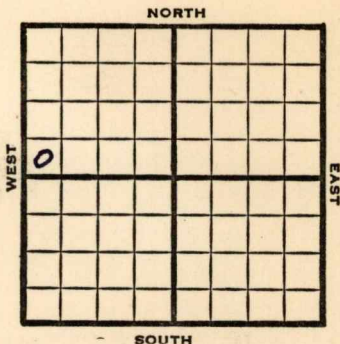

1952

Elev. 1315

REPORT

7/23

Location

8/13

Spud 7-31-52 D&A TD 2913

8" @78

Lans 1911 KC 2240 Miss 2872

TD 2913 D&A

ABANDONED

County Butler State KansasSec. 17 (Blk.
Twp.) 29 (Sur.
Rge.) 5E Map No.Operator Cappitt Drlg.Well No. 1 Farm QuallsElev. 1315 Location SW SW NW330 Ft. From S Line NW330 Ft. From W Line Quarter

1st. Report

Completion AUG 13 1952

Remarks

Cappitt Drlg. - Contr.Spudding Date 7-31-52Drlg. Data D & A TD 29138" @ 78 Lans. 1911 KC 2240 Miss. 2872TD 2913D & A