
Ellis KANSAS

SECTION 21 TOWNSHIP 14 RANGE 19W

WELL NO. #2 Perry

COMPANY Brunson Prod.

NORTH SE SE SW

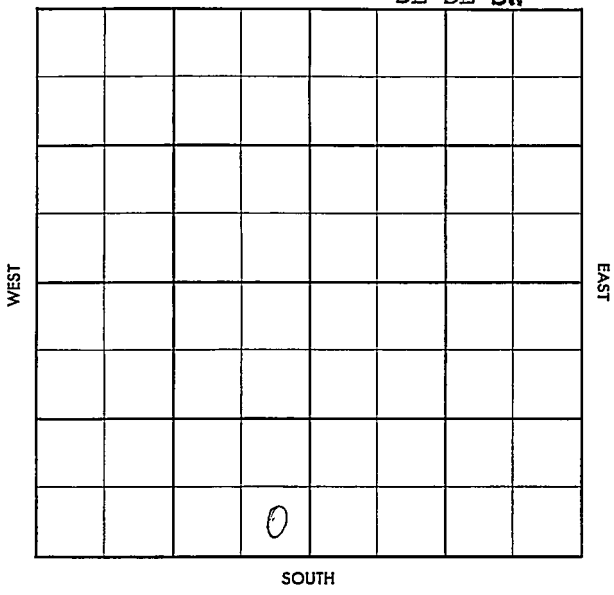

FORM 504-3 SUNRAY

FORM 513 SUNRAY

County Ellis Elev.

Sec. 21 Twp. 11 Rge. 19W

Company Brunson Prod.

Farm Name Perry No. 2

TOPS	DEPTH	LOG	DATUM
Anh.			
Tp.			
H.			
Tr.			
Dg.			
Bl.			
L.			
K.C.			
B.K.C.			
Ce.			
C.			
M.			
M.			
K.			
Mz.			
Mo.			
V.			
S.			
S.			
A			
R.			
P€.			
G.			
T.D.			

Loc. in Sec. SE SE SW

Geol.

Contr. Co. tools

Pool WILDCAT

FIRST REPORT

JAN 23 57

Date Comm. 1-21-57

8" @ 214/150 WOC

Co. Lse. No. Sec. T. R.

FORM 513 SUNRAY

County Ellis Elev. 2212

Sec. 21 Twp. 11 Rge. 17W

Company Benson Prod.

Farm Name Perry No. 2

TOPS	DEPTH	LOG	DATUM
Anh.			
Tp.			
H.	3461		
Tr.	3485		
Dg.			
Bl.			
L.	3508		
K.C.			
B.K.C.			
Ce.			
C.			
M.			
M.			
K.			
Mz.			
Mo.			
V.			
S.			
S.			
A	3832		
R.			
P€.			
G.			
T.D.	3838		

Loc. in Sec. SE SE SE

Geol.

Contr. Co. tools

Pool Wells

COMPLETE

FEB 27 '57

0

Date Comm. 1-27-57

8" @ 211/150 WOC [illegible] Ø 3[illegible]0

Ø 3710 FS [illegible] '57 DST 3794-3834

1hr 90' GCM + 550 FP 0-25#

DHP 950/20" 5½ 3834 FEB 13 '57

CO 3838 FO 600' oil 2 hrs FO

2400' oil no/w 12 hrs P.P.

FEB 20 '57 FEB 27 '57 Ph P. 108 Boyd

no/wtr grav 32°

Co. Lse. No. Sec. T. R.