

Map No. _____ Sec. 23 Twp. 29 R. 5
Well No. 1 W R Bush Farm _____
Benedum & Sons Company _____

NORTH

WEST

EAST

SOUTH

Location -----

Drilling Remarks:

Rig Up-----

Drilling Remarks:

RECORD

Cased _____ in _____ Ft.
 Sand _____
 Gas _____
 Oil _____
 Total Depth _____


PRODUCTION

1st 24 hrs. Nat-----
1st 24 hrs. after shot-----
Gas-----Cu. Ft.
Dry Hole-----
Abandoned -----

Map No. _____ Sec. 23 Twp. 29 R. 5
 Well No. 1 W. R. Bush Farm _____
Benedum & Trees Company _____

NORTH

WEST

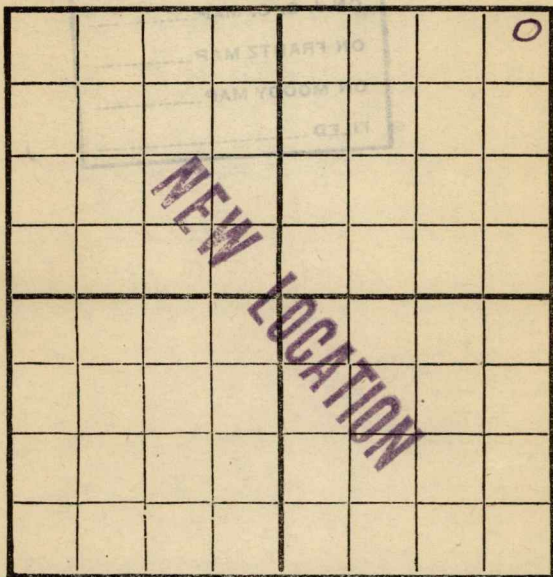

EAST

SOUTH

Location _____

Rig Up _____

Drilling and remarks

Loc.

RECORD

Cased _____ in. _____ Ft.

Sand _____

Gas _____

Oil _____

Total Depth _____

PRODUCTION

1st 24 hrs. Nat. _____

First 24 hrs. after shot _____

Gas _____ Cu. Ft.

Dry Hole _____

Abandoned _____

Date 1 1917

191

C. T. Crocker Scout

Butler

Map No. _____ Sec. *23* Twp. *29* R. *5*
 Well No. *1 W. R. Brush* Farm
Benedum & Treas Company

NORTH

							<i>0</i>

WEST

EAST

SOUTH

Location _____
 Rig Up _____
 Drilling and remarks _____

Rigging up

RECORD

Cased _____ in. _____ Ft.
 Sand _____
 Gas _____
 Oil _____
 Total Depth _____

PRODUCTION

1st 24 hrs. Nat. _____
 1st 24 hrs. after shot _____
 Gas _____ Cu. Ft.
 Dry Hole _____
 Abandoned _____

Date


4/28, 191 *7* *Crowder* Scout

Map No. _____ Sec. 23 Twp. 29 R. 5
 Well No. 1 Bush Farm _____
Bush & Trees Company

NORTH

WEST

EAST

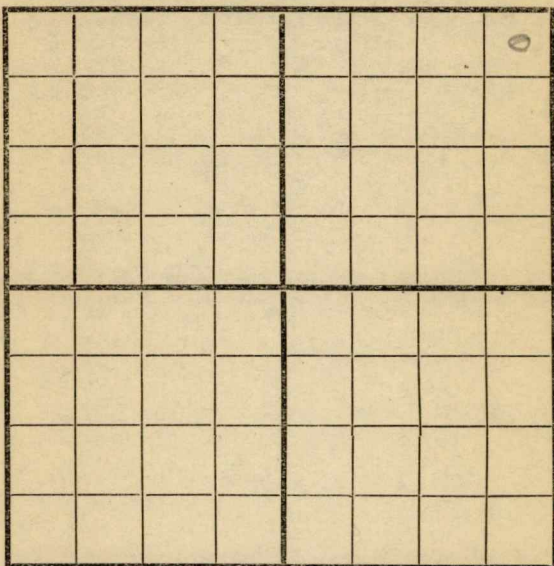

SOUTH

Location _____
 Rig Up _____
 Drilling and remarks _____

RECORD

Cased _____ in. _____ Ft.
 Sand _____
 Gas _____
 Oil _____
 Total Depth _____

PRODUCTION

1st 24 hrs. Nat. _____
 1st 24 hrs. after shot _____
 Gas _____ Cu. Ft.
 Dry Hole _____
 Abandoned _____

Date

5/2, 1917 Carly Scout

Map No. _____ Sec. 23 Twp. 29 R. 5
 Well No. 1 Bush _____ Farm
Pennington & Sons Company

NORTH

WEST

EAST

SOUTH

Location _____
 Rig Up ☒ _____
 Drilling and remarks _____

RECORD

Cased _____ in. _____ Ft.
 Sand _____
 Gas _____
 Oil _____
 Total Depth _____

PRODUCTION

1st 24 hrs. Nat. _____
 1st 24 hrs. after shot _____
 Gas _____ Cu. Ft.
 Dry Hole _____
 Abandoned _____


Date

5/7, 1917

Scout

Map No. _____ Sec. 23 Twp. 29 R. 5
 Well No. 1 Bush Farm _____
Benedict & Tree Company

NORTH

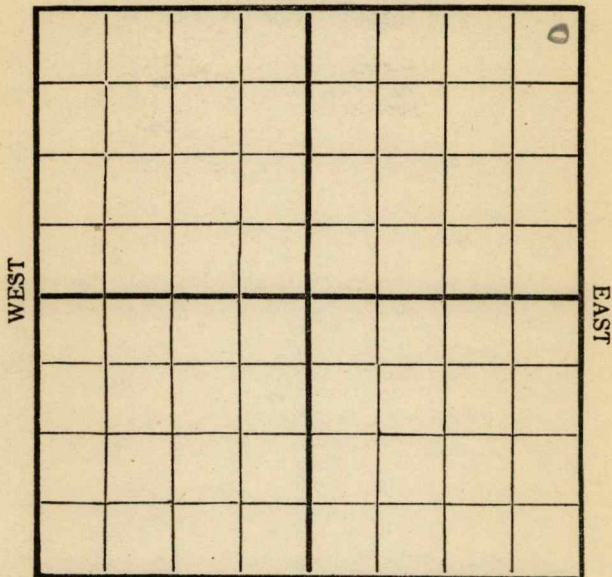

SOUTH

Location _____
 Rig Up _____
 Drilling and remarks

Spudding

RECORD

Cased _____ in. _____ Ft.
 Sand _____
 Gas _____
 Oil _____
 Total Depth _____

PRODUCTION

1st 24 hrs. Nat. _____
 1st 24 hrs. after shot _____
 Gas _____ Cu. Ft.
 Dry Hole _____
 Abandoned _____

Date


5/25 191 7 *Conroy* Scout

Map No. _____ Sec. 73 Twp. 29 R. 5
 Well No. 1 Bush Farm
Benedict & Trees Company

NORTH

WEST

EAST

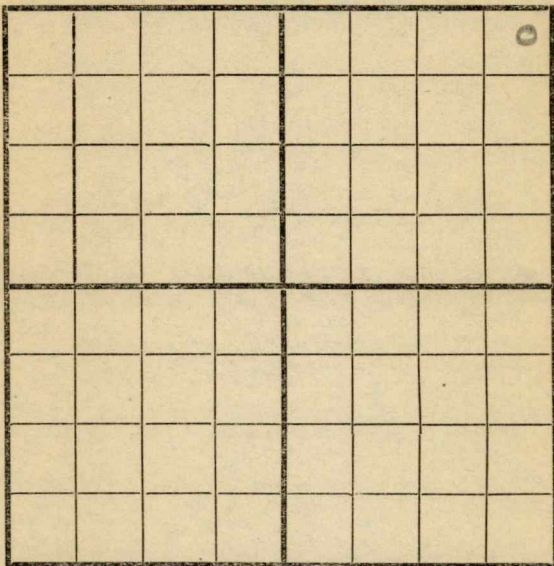

SOUTH

Location _____
 Rig Up _____
 Drilling and remarks

150

RECORD

Cased _____ in. _____ Ft.
 Sand _____
 Gas _____
 Oil _____
 Total Depth _____

PRODUCTION

1st 24 hrs. Nat. _____
 1st 24 hrs. after shot _____
 Gas _____ Cu. Ft.
 Dry Hole _____
 Abandoned _____

Date

5/29, 1917 Quincy Scout

Map No. _____ Sec. 23 Twp. 29 R. 5
 Well No. 1 Busby Farm _____
Benadum 49 miles Company _____

NORTH

WEST

EAST

SOUTH

Location _____

Rig Up _____

Drilling and remarks

230

RECORD

Cased _____ in. _____ Ft.

Sand _____

Gas _____

Oil _____

Total Depth _____

PRODUCTION

1st 24 hrs. Nat. _____

1st 24 hrs. after shot _____

Gas _____ Cu. Ft.

Dry Hole _____

Abandoned _____

Date

6/8, 1917 C. C. Cady Scout

Map No. _____ Sec. 23 Twp. 29 R. 5
 Well No. 1 Bush Farm _____
Benedict 99 Company _____

NORTH

WEST										EAST

SOUTH

Location _____
 Rig Up _____
 Drilling and remarks _____

Shut Down
230

RECORD

Cased _____ in. _____ Ft.
 Sand _____
 Gas _____
 Oil _____
 Total Depth _____

PRODUCTION

1st 24 hrs. Nat. _____
 1st 24 hrs. after shot _____
 Gas _____ Cu. Ft.
 Dry Hole _____
 Abandoned _____

Date 6/12 191 7 Cardiff Scout

Map No. _____ Sec. 23 Twp. 29 R. 5
 Well No. 1 Bush Farm _____
Boneland Trees Company

NORTH

WEST									EAST

SOUTH

Location _____
 Rig Up _____
 Drilling and remarks

300

RECORD

Cased _____ in. _____ Ft.
 Sand _____
 Gas _____
 Oil _____
 Total Depth _____

PRODUCTION

1st 24 hrs. Nat. _____
 1st 24 hrs. after shot _____
 Gas _____ Cu. Ft.
 Dry Hole _____
 Abandoned _____

Date

6/25, 1917 Cordell Scout

Map No. _____ Sec. 33 Twp. 29 R. 5
 Well No. 1 Bush Farm _____
Bush & Sons Company

NORTH

							0

SOUTH

Location _____
 Rig Up _____
 Drilling and remarks

700

RECORD

Cased _____ in. _____ Ft.
 Sand _____
 Gas _____
 Oil _____
 Total Depth _____


PRODUCTION

1st 24 hrs. Nat. _____
 1st 24 hrs. after shot _____
 Gas _____ Cu. Ft.
 Dry Hole _____
 Abandoned _____

Date 6/27, 1917 Carly Scout

Map No. _____ Sec. 23 Twp. 29 R. 5
 Well No. 1 Brusley Farm _____
Benedict & Sons Company _____

NORTH

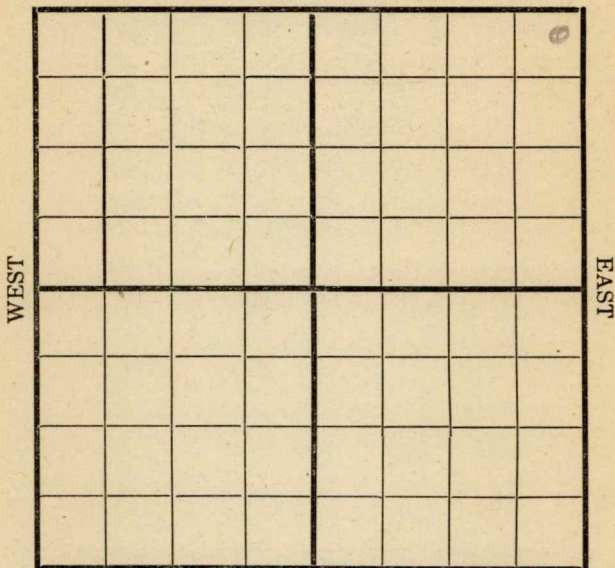

SOUTH

Location _____
 Rig Up _____
 Drilling and remarks _____

RECORD

Cased _____ in. _____ Ft.
 Sand _____
 Gas _____
 Oil _____
 Total Depth _____

PRODUCTION

1st 24 hrs. Nat. _____
 1st 24 hrs. after shot _____
 Gas _____ Cu. Ft.
 Dry Hole _____
 Abandoned _____


Date

7/6, 1917 Cooley Scout

Map No. _____ Sec. 23 Twp. 29 R. 5Well No. 1 Brush Farm
Benedict & Sons Company

NORTH

WEST

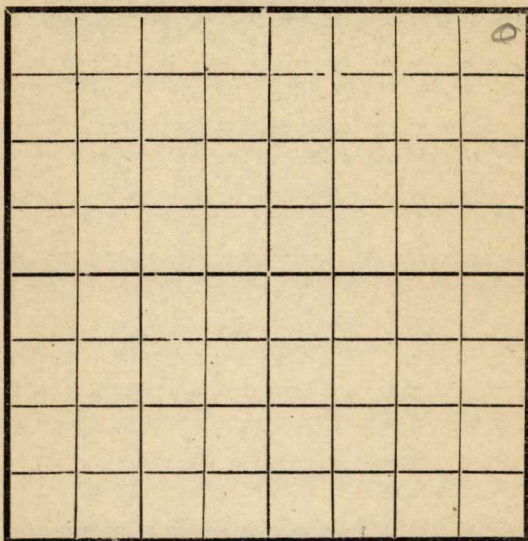

EAST

SOUTH

RECORD

Location _____

Rig Up _____

Drilling and remarks _____

Cased _____ in. _____ Ft.

Sand _____

Gas _____

Oil _____

Total Depth _____

PRODUCTION

1st 24 hrs. Nat. _____

1st 24 hrs. after shot _____

Gas _____ Cu. Ft.

Dry Hole _____

Abandoned _____

Date

7/11, 1919 Brush Scout


Map No. _____ Sec. 23 Twp. 29 R. 5

Well No. 13 Farm _____

Benedict & Sons Company

NORTH

WEST

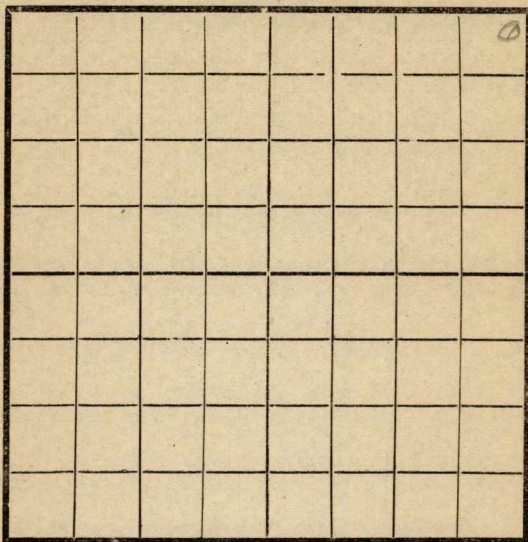

EAST

SOUTH

Location _____

Rig Up _____

Drilling and remarks

RECORD

Cased _____ in. _____ Ft.

Sand _____

Gas _____

Oil _____

Total Depth _____

PRODUCTION

1st 24 hrs. Nat. _____

1st 24 hrs. after shot _____

Gas _____ Cu. Ft.

Dry Hole _____

Abandoned _____


Date

7/12, 1917 Candy Scout

Map No. _____ Sec. 23 Twp. 29 R. 5Well No. 1 Bush FarmBendone & Co. Company

NORTH

WEST

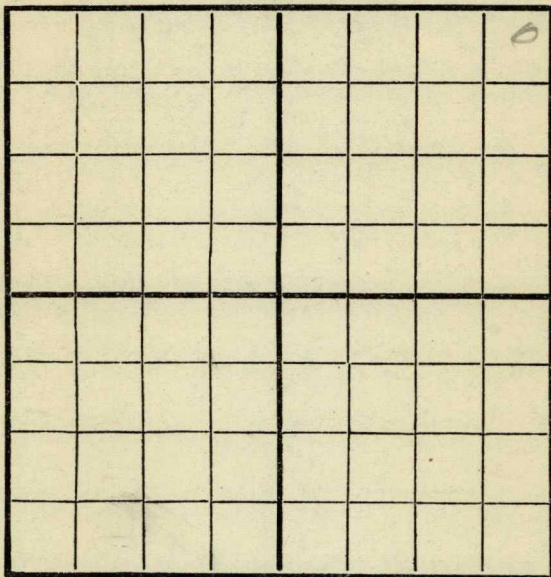

EAST

SOUTH

Location _____

Rig Up _____

Drilling and remarks

Shut Down
1600'

RECORD

Cased _____ in. _____ Ft.

Sand _____

Gas _____

Oil _____

Total Depth _____

PRODUCTION

1st 24 hrs. Nat. _____

1st 24 hrs. after shot _____

Gas _____ Cu. Ft.

Dry Hole _____


Abandoned _____

Date

8/1, 1911 C. C. C. Scout

Map No. _____ Sec. 23 Twp. 29 R. 5Well No. 1 Brush Farm
Benedict & Tress Company

NORTH

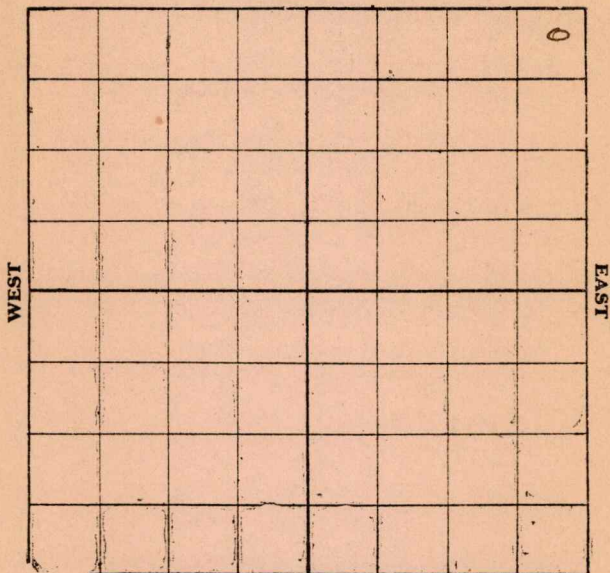

SOUTH

Location _____

Rig up _____

Drilling and Remarks:

*Shut Down
to Repair Rig
at 1600'*

RECORD

Cased _____ in. _____ Ft.

Sand _____

Gas _____

Oil _____

Total Depth _____

PRODUCTION

1st 24 hrs. Nat. _____

1st 24 hrs. after shot _____

Gas _____ Cu. Ft.

Dry Hole _____

Abandoned _____


Date

7/24, 1917, J. Cardy Scout

Map No. _____ Sec. 23 Twp. 29 R. 5
 Well No. 1 Brush Farm _____
Benedict & Tress Company

NORTH

WEST

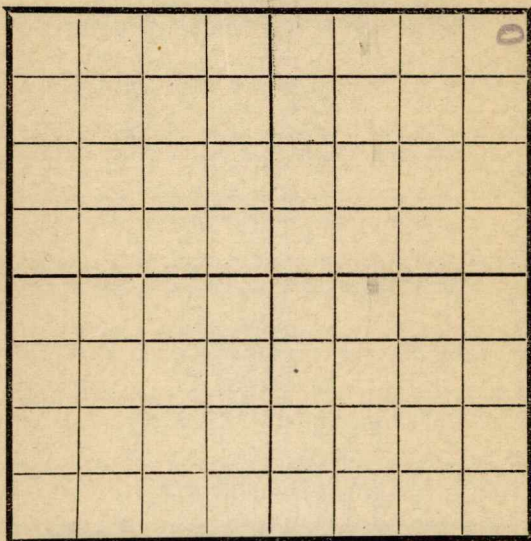

EAST

SOUTH

Location _____
 Rig Up _____
 Drilling and remarks

1740

RECORD

Cased _____ in. _____ Ft.
 Sand _____
 Gas _____
 Oil _____
 Total Depth _____

PRODUCTION

1st 24 hrs. Nat. _____
 1st 24 hrs. after shot _____
 Gas _____ Cu. Ft.
 Dry Hole _____
 Abandoned _____


Date

8/17, 1917 C. E. Cady Scout

Map No. _____ Sec. 23 Twp. 29 R. 5
 Well No. 1. M. R. Brush Farm
B. Buchanan & Sons Company

NORTH

WEST

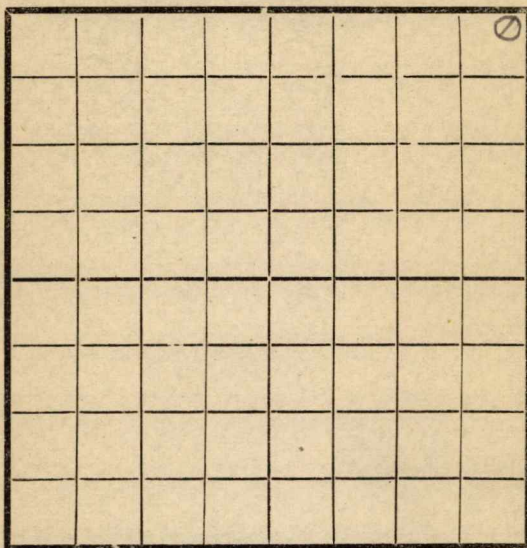

EAST

SOUTH

Location _____

Rig Up _____

Drilling and remarks

at 1800.

RECORD

Cased _____ in. _____ Ft.

Sand _____

Gas _____

Oil _____

Total Depth _____

PRODUCTION

1st 24 hrs. Nat. _____

1st 24 hrs. after shot _____

Gas _____ Cu. Ft.

Dry Hole _____


Abandoned _____

Date

8-20, 1917 Lantz Scout

Map No. _____ Sec. 23 Twp. 29 R. 5
 Well No. 1 Brush Farm _____
Beardman 99/100 Company _____

NORTH

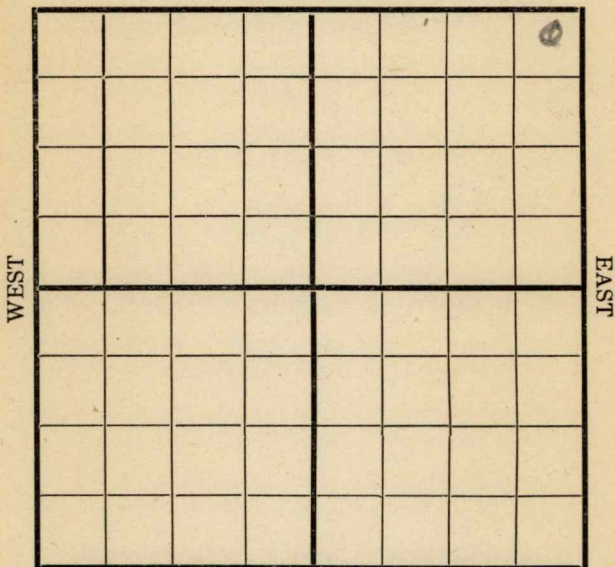

SOUTH

Location _____

Rig Up _____

Drilling and remarks

2100

RECORD

Cased _____ in. _____ Ft.

Sand _____

Gas _____

Oil _____

Total Depth _____

PRODUCTION

1st 24 hrs. Nat. _____

1st 24 hrs. after shot _____

Gas _____ Cu. Ft.

Dry Hole _____

Abandoned _____

Date

9/5, 1917 7 Conley Scout

Map No. _____ Sec. 23 Twp. 39 R. 5
 Well No. 1 Brush Farm _____
Benedict & Sons Company

NORTH

WEST

EAST

SOUTH

Location _____

Rig Up _____

Drilling and remarks

RECORD

Cased _____ in. _____ Ft.

Sand _____

Gas _____

Oil _____

Total Depth _____

PRODUCTION

1st 24 hrs. Nat. _____

1st 24 hrs. after shot _____

Gas _____ Cu. Ft.

Dry Hole _____


Abandoned _____

Date

9/14, 1917. Carley Scout

Map No. _____ Sec. 23 Twp. 29 R. 5Well No. 1 Bruner Farm
Benedict & Sons Company

NORTH

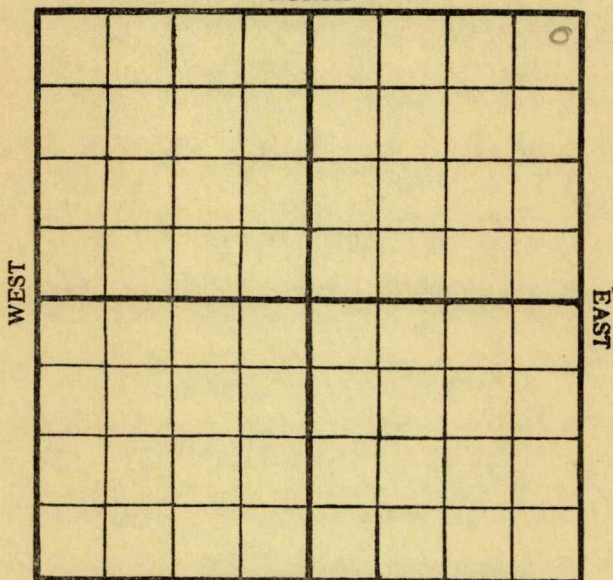

SOUTH

Location _____

Rig Up _____

Drilling and remarks

2550

RECORD

Cased _____ in. _____ Ft.

Sand _____

Gas _____

Oil _____

Total Depth _____

PRODUCTION

1st 24 hrs. Nat. _____

1st 24 hrs. after shot _____

Gas _____ Cu. Ft.

Dry Hole _____

Abandoned _____


Date

9/19, 1917 Cordiff Scout

Map No. _____ Sec. 33 Twp. 29 R. 5
 Well No. 1 Brush Farm _____
Benedict & Sons Company

NORTH

WEST

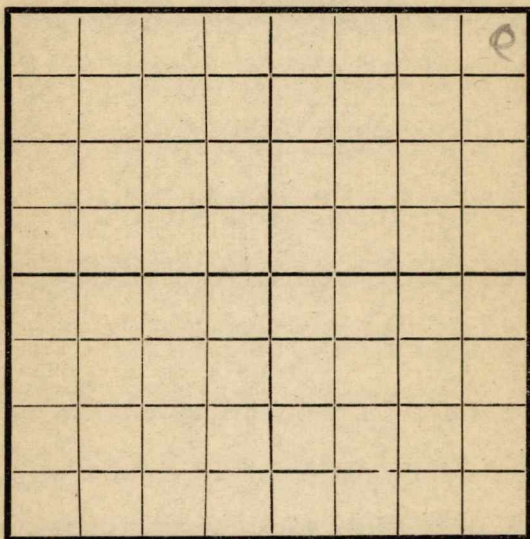

EAST

SOUTH

Location _____
 Rig Up _____
 Drilling and remarks

RECORD

Cased _____ in _____ Ft.
 Sand _____
 Gas _____
 Oil _____
 Total Depth _____

PRODUCTION

1st 24 hrs. Nat. _____
 1st 24 hrs. after shot _____
 Gas _____ Cu. Ft.
 Dry Hole _____
 Abandoned _____

Date


9/27, 1912 Carley Scout

Map No. _____ Sec. 33 Twp. 29 R. 5
Well No. 1 Brunson Farm
Brunson 99 Company

NORTH

WEST

EAST

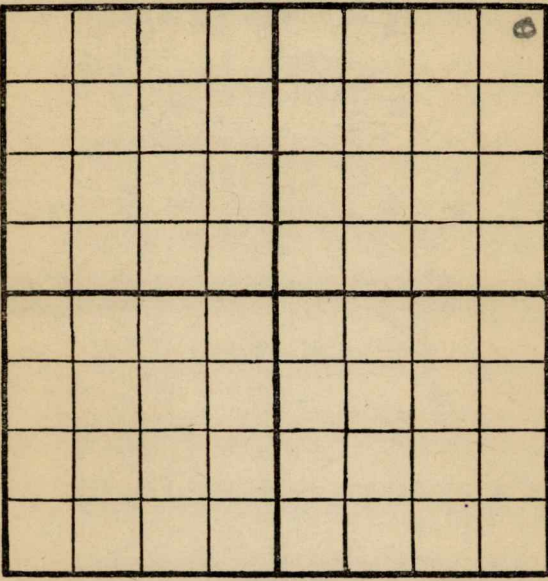

SOUTH

Location _____
Rig Up _____
Drilling and remarks
Top sand
2808'

RECORD

Cased _____ in. _____ Ft.
Sand _____
Gas _____
Oil _____
Total Depth _____

PRODUCTION


1st 24 hrs. Nat. _____
1st 24 hrs. after shot _____
Gas _____ Cu. Ft.
Dry Hole _____
Abandoned _____

Date 10/6, 1917, Candice Scout

Map No. _____ Sec. 23 Twp. 24 R. 5Well No. 1 _____ FarmBennett & Trues Company

NORTH

WEST

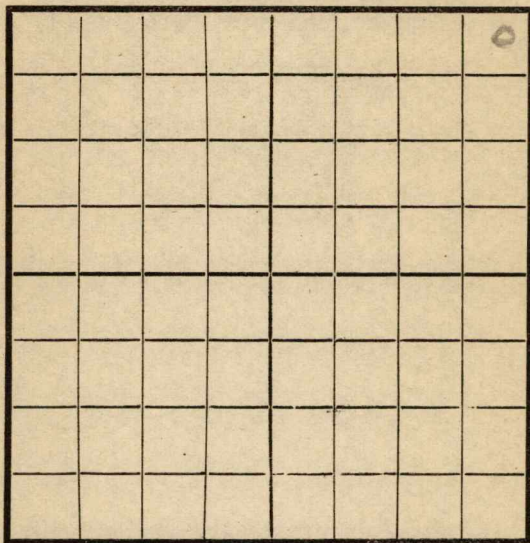

EAST

SOUTH

RECORD

Location _____

Rig Up _____

Drilling and remarks

Cased _____ in. _____ Ft.

Sand 2820-2855

Gas _____

Oil _____

Total Depth _____

PRODUCTION

1st 24 hrs. Nat. _____

1st 24 hrs. after shot _____

Gas _____ Cu. Ft.

Dry Hole _____


Abandoned _____

Date

10/9, 1917 C. L. L. L. Scout

Map No. _____ Sec. 33 Twp. 29 R. 5Well No. 1 Brush FarmSennedum & Tree Company

NORTH

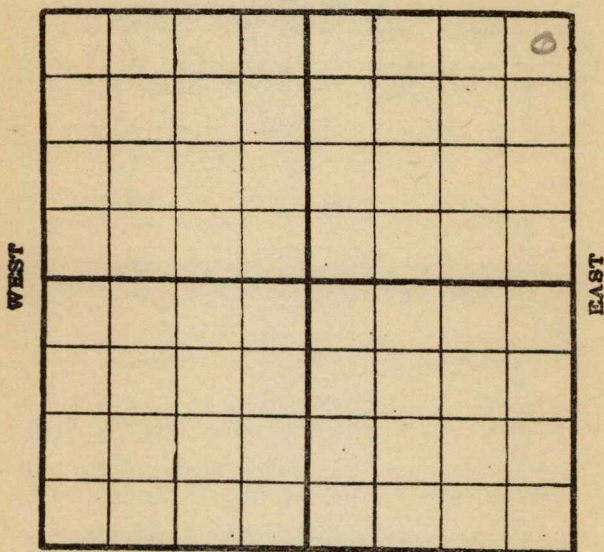

SOUTH

Location _____

Rig up _____

Drilling and remarks:

2925'

RECORD

Cased _____ in. _____ Ft.

Sand _____

Gas _____

Oil _____

Total Depth _____

PRODUCTION

1st. 24 hrs. Nat. _____

1st. 24 hrs. after shot _____

Gas _____ Cu. Ft.

Dry Hole _____

Abandoned _____


Date

10/17 1917 J. Carley Scout

Map No. _____ Sec. 33 Twp. 29 R. 5Well No. 1 Brush Farm
Burden & Trex Company

NORTH

WEST

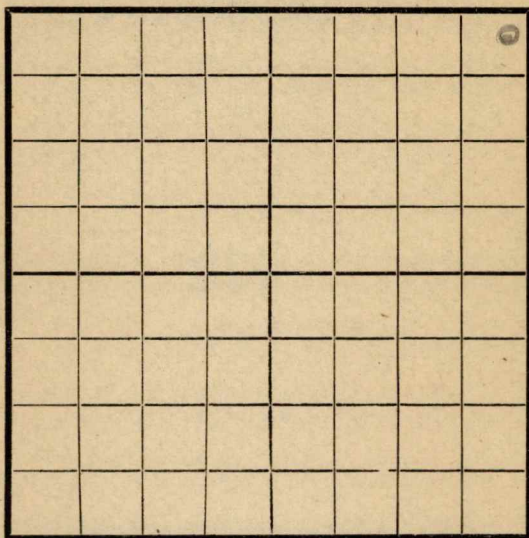

EAST

SOUTH

Location _____

Rig Up _____

Drilling and remarks

Isling
3015

RECORD

Cased _____ in. _____ Ft.

Sand _____

Gas _____

Oil _____

Total Depth _____

PRODUCTION

1st 24 hrs. Nat. _____

1st 24 hrs. after shot _____

Gas _____ Cu. Ft.

Dry Hole _____

Abandoned _____


Date

10/24, 191 *2* *Can. Oil* Scout

Map No. _____ Sec. 23 Twp. 29 R. 5Well No. 1 Brush Farm
Benedict & Tress Company

NORTH

WEST

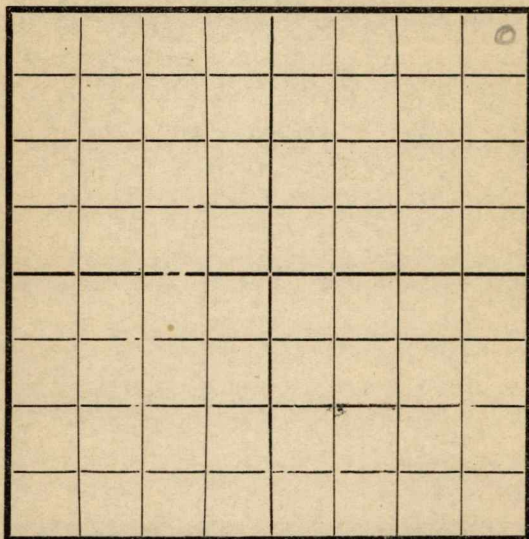

EAST

SOUTH

Location _____

Rig Up _____

Drilling and remarks

Fishing 3015

RECORD

Cased _____ in. _____ Ft.

Sand _____

Gas _____

Oil _____

Total Depth _____

PRODUCTION

1st 24 hrs. Nat. _____

1st 24 hrs. after shot _____

Gas _____ Cu. Ft.

Dry Hole _____

Abandoned _____


Date

10/31, 1912 Cardiff Scout

Map No. _____ Sec. 23 Twp. 29 R. 5Well No. 1 Bush Farm _____Bush & Trees Company _____

NORTH

WEST

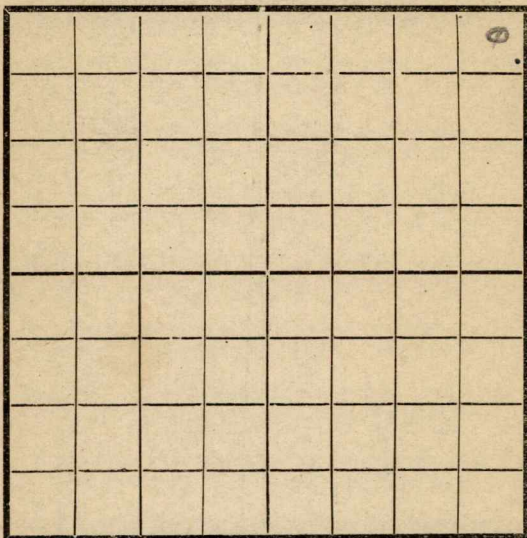

EAST

SOUTH

Location _____

Rig Up _____

Drilling and remarks

22 3015

RECORD

Cased _____ in. _____ Ft.

Sand _____

Gas _____

Oil _____

Total Depth _____

PRODUCTION

1st 24 hrs. Nat. _____

1st 24 hrs. after shot _____

Gas _____ Cu. Ft.

Dry Hole _____

Abandoned _____


Date

11-7, 1912 Carly Scout

Map No. _____ Sec. 23 Twp. 29 R. 5Well No. 1 Brush FarmBendum & Trees Company

NORTH

WEST

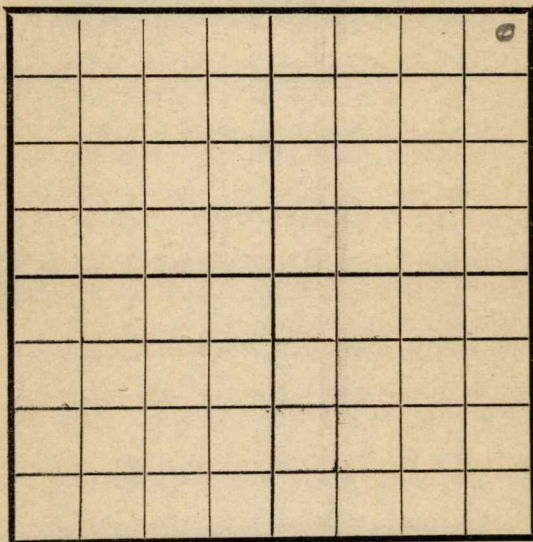

EAST

SOUTH

Location _____

Rig Up _____

Drilling and remarks

Will shoot
this sum
where they
had a showing
Plugging back
from 3015

RECORD

Cased _____ in. _____ Ft.

Sand 2820-2855

Gas _____

Oil _____

Total Depth 3015

PRODUCTION

1st 24 hrs. Nat. _____

1st 24 hrs. after shot _____

Gas _____ Cu. Ft.

Dry Hole _____

Abandoned _____


Date

11-14-2 Conley Scout

Map No. _____ Sec. 23 Twp. 29 R. 5Well No. 1 Bruner Farm
Benedict & Trees Company

NORTH

WEST

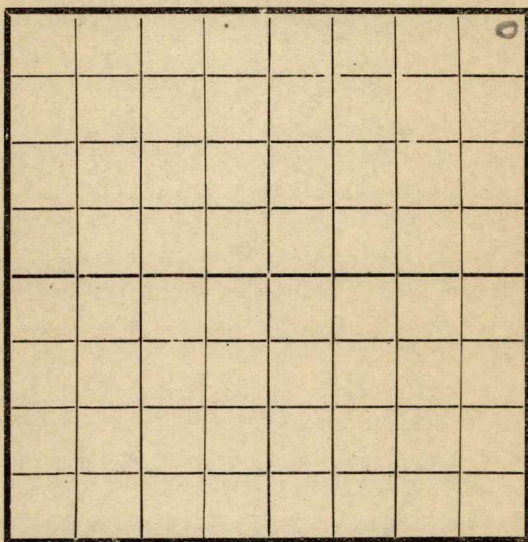

EAST

SOUTH

Location _____

Rig Up _____

Drilling and remarks

Shut Down
2855'

RECORD

Cased _____ in _____ Ft.

Sand _____

Gas _____

Oil _____

Total Depth _____

PRODUCTION

1st 24 hrs. Nat. _____

1st 24 hrs. after shot _____

Gas _____ Cu. Ft.

Dry Hole _____

Abandoned _____


Date

11/21, 191 *7* *Carney* Scout

Map No. _____ Sec. 23 Twp. 29 R. 5Well No. 1 Brush Farm
Bending Trees Company

NORTH

WEST

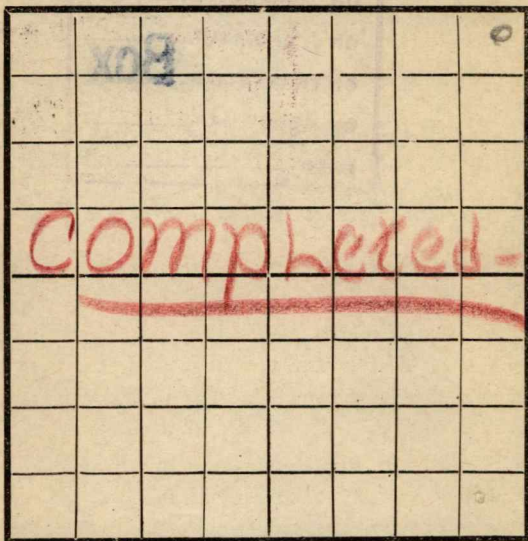

EAST

SOUTH

Location _____

Rig Up _____

Drilling and remarks

2855'
Shot with 60
gts - Est gun
for 40 lbs

RECORD

Cased _____ in. _____ Ft.

Sand 2820-2855

Gas _____

Oil _____

Total Depth _____

PRODUCTION

1st 24 hrs. Nat. _____

1st 24 hrs. after shot _____

Gas _____ Cu. Ft.

Dry Hole _____

Abandoned _____

Date

11/28, 1917 Condy Scout