


Butler

Section 23 Township 29S Range 5E

KANSAS

Well No. #3 Corbett

Company H.H. Blair

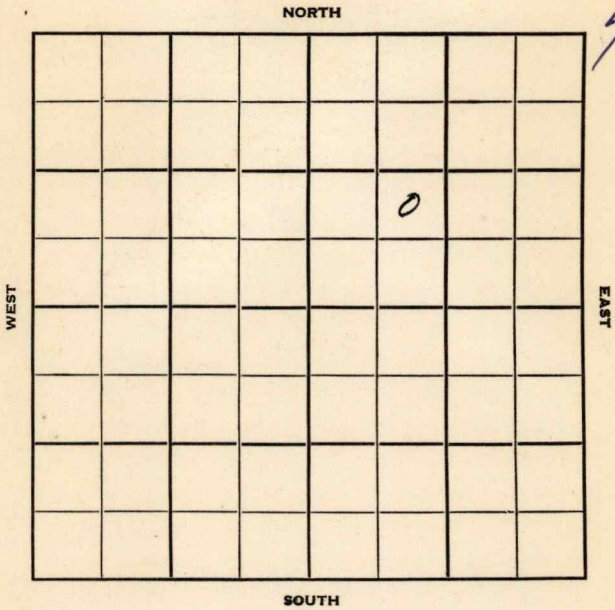

Sec. 23 Twp. 29 R. 5 E ✓

Well No. # 3 Corbett Farm

H H. Blair Company

H & M Drlg. Contractor

Fox-Bush Pool


Ft. from N. Line

990 Ft. from S. Line

Ft. from E. Line

990 Ft. from W. Line

NE SW NE

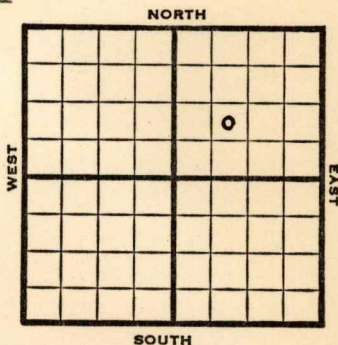

1952

Elev. 1356' REPORT

1/2 Location

1/30 Oil Well TD 2833  
 KC 2178 Bart. 2763  
 Miss 2833 TD 2833  
 7" @ 2795 Comp. F/30 bopd

**COMPLETED**



