

Section 22 Township 29 Range 5 EWell No. # 1 Langston HackettCompany B.V. Cox

0							

NORTH

WEST

EAST

SOUTH

13

Butler

KANSAS ✓

Sec. 22 Twp. 29 R. 5EWell No. 1 Hackett
Langston Farm

B.V. Cox

Company

Rex & Morris

Contractor

Wildcat

Ft. from N. Line

330


Ft. from S. Line

Ft. from E. Line

330

Ft. from W. Line

SW SW SW

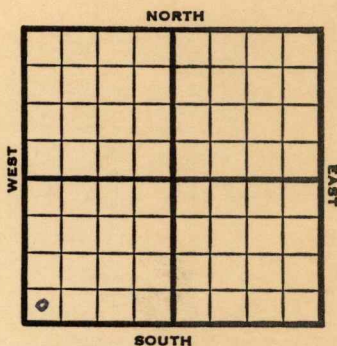

1953

Elev. 1308'

REPORT

4/15

Location

5/20

Spud 5-8-53

D & A

TD 2851'

8" @ 101'

KC 2182, Bart 2740, Miss 2831

TD 2851'

D & A.

ABANDONED

County **Butler** State **Kansas**

Sec. **22** (Blk. Twp.) **29** (Sur. Rge.) **5E** Map No.

Operator **B. V. Cox**

Well No. 1 Farm Langston

[illegible]

330 Ft. From S Line SW

330 Ft. From W Line Quarter

1st. Report APR 15 1953

Completion

Remarks Rex & Morris - DHM

Rex & Morris - Contr.

Spudding Date _____

Drlg. Data Wildcat

Location

J. G. McGEHEE

Kansas

Map No. _____ Sec. 22 Twp. 29 R. 5EWell No. 1 Hackett

_____ B. V. Cox _____ Company

_____ **CORRECTION** _____ Contractor


SW SW SW

SECTION PLAT

_____ Ft. from N. Line

330 Ft. from S. Line

_____ Ft. from E. Line

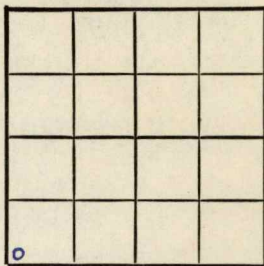330 Ft. from W. Line

Butler County

Location _____

Rig up _____

Drilling and Remarks:

Reported
#1 Langston

RECORD

Cased _____ in., _____ ft.

Sand _____

Gas _____

Oil _____

Total Depth _____

PRODUCTION

1st 24 hrs. Nat. _____

1st 24 hrs. after shot _____

Gas _____ Cu. Ft.

Dry Hole _____

Abandoned _____

Date

MAY 8 1953 19

J. G. McGEHEE Scout

County Butler State Kansas

Sec. 22 (Blk. Twp.) 29 (Sur. Rge.) 5E Map No.

Operator B. V. Cox

Well No. 1 Farm Hackett

Elev.	1308	Location	SW SW SW
-------	------	----------	----------

330 Ft. From S Line SW

330 Ft. From W Line Quarter

1st. Report

Completion MAY 20 1953

Remarks Wildcat

Rex & Morris - Contr.

Spudding Date 5-8-53

Drig. Data D & A TD 2851

8" @ 101 KC 2182 Bart. 2740 Miss. 2831

TD 2851

D & A

J. G. McGEHEE