Form 51—5M—11-38—Palace

O.W.D.D


McPherson KANSAS

Section 18 Township 17 Range 1-W

Well No. #2 Union

C R A

Company Western Kansas O&R

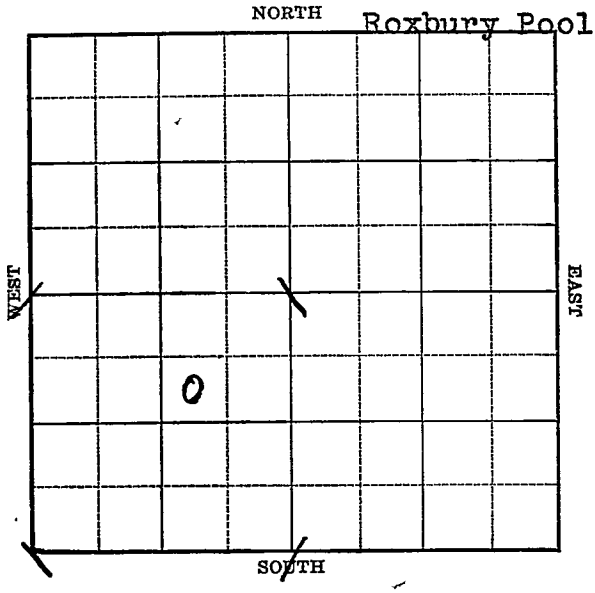

FORM 252-A 5M-4-39 KANSAS McPherson

Sec. 18 Twp. 17 R. 1-W

Well No. #2 Union Farm

Western Kansas O & G Company

(Roxbury) O.W.D.D


990 Ft. from N. Line

Ft. from S. Line

990 Ft. from E. Line

Ft. from W. Line

Elev. 1372

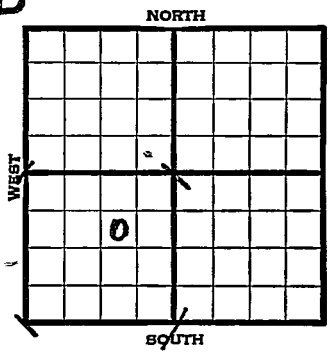

1939	REPORT
6/14	Rotary.
6/23	Rigging up.
6/29	13" - 155' Drlg. 2180'
7/6	Chat. 2682' 6" - 2682'
	T.D. 2683' RUST.
7/13	T.D. 2688' Swab 12 bbls. per
	hour. 1000 acid. Testing.
7/19	Chat. 2682'
	6" - 2682'
	T.D. 2688'
	1000 acid.
	Pump 598 bbls.
	COMPLETED
1950	O.W.D.D
3/22	Miss 2680' OTT 2688'
	6"@ 2682' Drld deeper to Hunton 3022'
	Maquoketa 3105'
	Drlg. @ 3165'
	OVER

1950

3/29 TD 3313'
Old TD 2688'
Hunton 3022'
Maquoketa 3105'
Viola 3198'
Simp sd 3297'
D&A
Aband.

ABANDONED

Form 26—1M Bks.—2-29 McPherson KANSAS

Map No. 42 Sec. 18 Twp. 17 R. 1W

Well No. 2 Union

Western Kansas Oil & Refg. Company

Contractor

FIRST REPORT

SW NE SW

990 Ft. from N. Line


_____ Ft. from S. Line

_____ Ft. from E. Line

990 Ft. from W. Line

ROXBURY POOL

SECTION PLAT

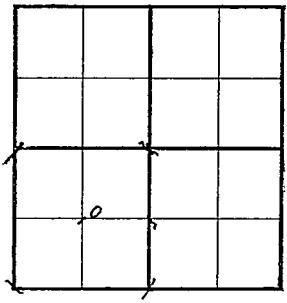

Location _____

Rig up _____

Drilling and Remarks:

Rotary

RECORD

Cased _____ in., _____ ft.

Sand _____

Gas _____

Oil _____

Total Depth _____

PRODUCTION

1st 24 hrs. Nat. _____

1st 24 hrs. after shot _____

Gas _____ Cu. Ft.

Dry Hole _____

Abandoned _____

Date

JN 14 1939 19


S. J. LEWIS Scout

Lewis - Please check spot on plat with ft. Meas. Thanks.

Pittman

Lewis:--Please check & advise.

Don Schumaker

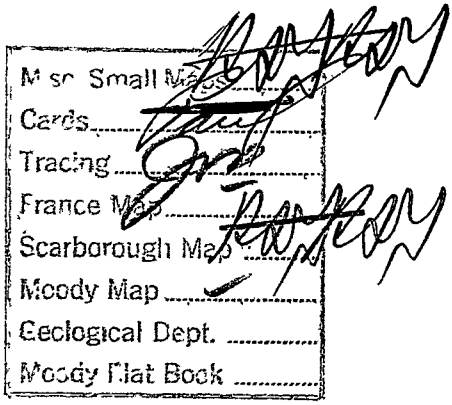

Form 26—1M Bks.—2-29 McPherson KANSAS

Map No. 42 Sec. 18 Twp. 17 R. 1W

Well No. 2 Union

Western Kansas O & R Company

Contractor

CORRECTION

SW NE SW

990 Ft. from N. Line


Ft. from S. Line

990 Ft. from E. Line

Ft. from W. Line

Roxbury Pool

SECTION PLAT

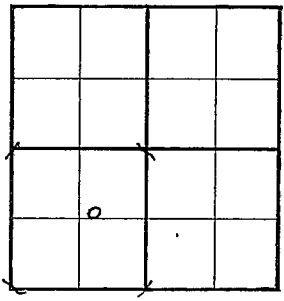

Location

Rig up

Drilling and Remarks:

ROTARY

RECORD

Cased in., ft.

Sand

Gas

Oil

Total Depth

PRODUCTION

1st 24 hrs. Nat.

1st 24 hrs. after shot

Gas Cu. Ft.

Dry Hole

Abandoned

Date

JUN 21 1939

19

S. J. LEWIS Scout

Form 26—1M Bks.—2-29

McPherson KANSAS

Map No. 42 Sec. 18 Twp. 17 R. 1W

Well No. 2 Union

Western Kansas O & R Company

Contractor

COMPLETED

SW NE SW

990 Ft. from N. Line


_____ Ft. from S. Line

_____ Ft. from E. Line

990 Ft. from W. Line

ROXBURY POOL

SECTION PLAT

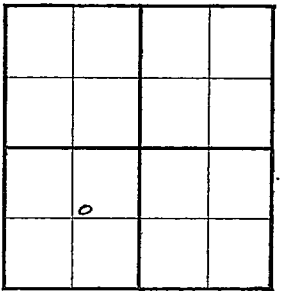

Location _____

Rig up _____

Drilling and Remarks:

Chat 2682.

6" @ 2682.

1000 acid

Pump 598

RECORD

Cased _____ in., _____ ft.

Sand _____

Gas _____

Oil _____

Total Depth 2688

PRODUCTION

1st 24 hrs. Nat. _____

1st 24 hrs. after shot _____

Gas _____ Cu. Ft.

Dry Hole _____

Abandoned _____

Date

JUL 19 1933 19

S. J. LEWIS Scout

Form 26 200 Bks. 11-49 Petrol Kansas OWDD

Map No. Sec. 18 Twp. 17 R. 1W

Well No. 2 Union

C R A Company

Contractor

SW NE SW **O. W. D. D** El. 1372

SECTION PLAT

990 Ft. from N. Line

Ft. from S. Line

990 Ft. from E. Line

Ft. from W. Line



McPherson County

Location

Rig up

Drilling and Remarks:

Miss. 2680
OTD 2688
6" @ 2682
drld deeper to
Hunton 3022
Maquoketa 3105
drlg. @ 3165

RECORD

Cased in., ft.

Sand

Gas

Oil

Total Depth

PRODUCTION.

1st 24 hrs. Nat.

1st 24 hrs. after shot

Gas Cu. Ft.

Dry Hole

Abandoned

Date

MAR 2 2 1950 19

J. E. TYRA Scout

Form 26 200 Bks. 11-49 Petrol

Kansas

OWDD

Map No. ____ Sec. 18 Twp. 17 R. 1W

Well No. 2 Union


C R A
Company

Contractor

SW NE SW

El. 1372

SECTION PLAT

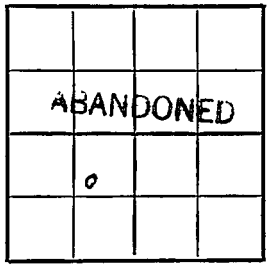

990 Ft. from N. Line

Ft. from S. Line

990 Ft. from E. Line

Ft. from W. Line

McPherson County

Location

Rig up

Drilling and Remarks:

old T.D. 2688
Hunton 3022
Maquoketa 3105
Viola 3198
Simp Sd 3297
D & A

RECORD

Cased ____ in., ____ ft.

Sand

Gas

Oil

Total Depth 3313

PRODUCTION

1st 24 hrs. Nat.

1st 24 hrs. after shot

Gas ____ Cu. Ft.

Dry Hole

Abandoned

Date

MAR 29 1950
19

J. E. TYRA
Scout