


Kansas

Map No. _____ Sec. 23 Twp. 29 R. 5

Well No. 1 Brush Bellport Farm Company

4

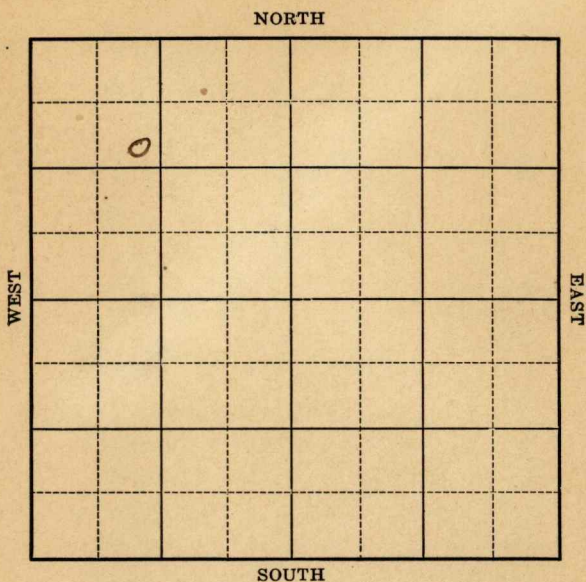

Location _____

Drilling Remarks: _____

Rig Up _____

Drilling Remarks: _____

FIRST REPORT

RECORD

Cased _____ in. _____ ft.
Sand _____
Gas _____
Oil _____
Total Depth _____

PRODUCTION

1st 24 hrs. Nat. _____
1st 24 hrs. after shot _____
Gas _____ cu. ft.
Dry Hole _____
Abandoned _____

Map No. **KANSAS** 11 23 Sec. Twp. 29 3 R.

Well No. *1 Bush*
Bellport Company

Contractor

FIRST REPORT

SECTION PLAT

1120 Ft. from N. Line

----- Ft. from S. Line

----- Ft. from E. Line

1120 Ft. from W. Line

o			

Location -----

Rig up *✓✓* -----

Drilling and Remarks:

spud

RECORD

Cased ----- in., ----- ft.

Sand -----

Gas -----

Oil -----

Total Depth -----

PRODUCTION

1st 24 hrs. Nat. -----

1st 24 hrs. after shot -----

Gas ----- Cu. Ft.

Dry Hole -----

Abandoned -----

Date

NOV 24 1922

M. A. BENEAR

----- 191 -----

Scout

11 **KANSAS** Map No. _____ Sec. 23 Twp. 29 R. 5

Well No. 1 Brush _____

Bellport et al _____ Company

_____ Contractor

ABANDONED SECTION PLAT

1120 Ft. from N. Line

_____ Ft. from S. Line

_____ Ft. from E. Line

1120 Ft. from W. Line

0			

Location _____

Rig up _____

Drilling and Remarks:

RECORD

Cased _____ in., _____ ft.

Sand _____

Gas _____

Oil _____

Total Depth _____

PRODUCTION

1st 24 hrs. Nat. _____

1st 24 hrs. after shot _____

Gas _____ Cu. Ft.

Dry Hole _____

Abandoned 1200'

Date

3/20 1925

M. A. BENEAR

Scout