


Section 21 Township 14 Range 19WWell No. #1 Kraus "A"Company Colorado Oil & Gas

NORTH

WEST

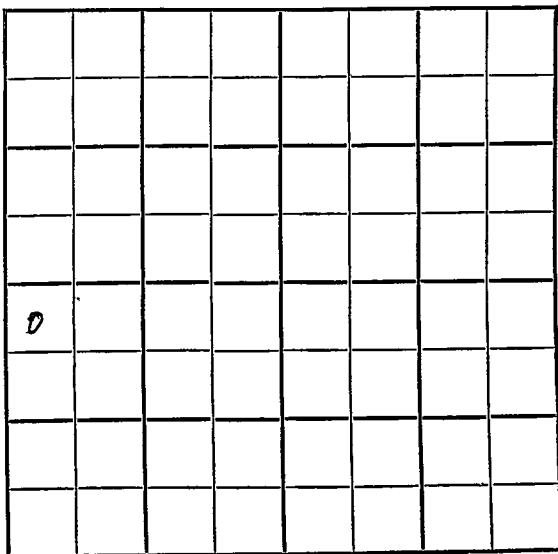

EAST

SOUTH


ELLIS		KANSAS
SEC.	TWP.	R.
21	14	19W
#1 Kraus "A"		FARM
COMPANY		
Colorado O & G		
CONTRACTOR		
Coppinger.		

330 _____ Ft. from N. Line

_____ Ft. from S. Line

_____ Ft. from E. Line


330 _____ Ft. from W. Line

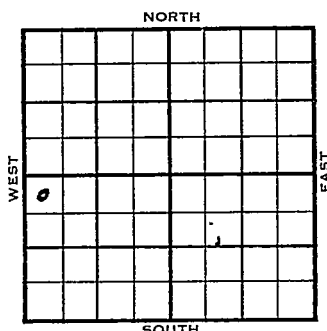

NW NW SW

1955	ELEVATION	REPORT
	2209'	
2/23	M I R	
3/16	Spud 2-26-55 D&A TD 3870 8" @ 192 anhy 1491, Heeb 3464, Tor. 3485, Lans 3511, B KC 3758 Marm 3794, DST 3796-3808 open 1 hr Rec 25' mud 0# Cong. 3814, Gorham 3821 DST 3827-32 open 1/2 hr Rec. 15' mud 0# Arb 3825 DST 3829-40 open 1/2 hr Rec 15' SOCM 850# DST 3806-28 open 2 hr Rec 5' mud 30# DST 3836-44, open 1 hr 50 min, Rec 5' oil, 40' OCM 15' mud 1025# TD 3870 D&A	
	ABANDONED	

County Ellis State Kansas
 Sec. 21 (Blk.) 14 (Sur.) 19W Map No.
 Operator Colorado Oil & Gas
 Well No. 1 Farm Kraus "A"
 Elev. 2209 Location NW NW SW

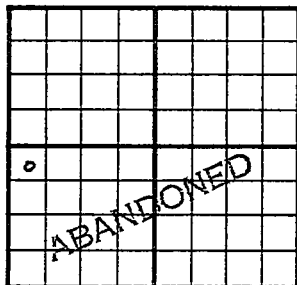

330Ft. From N Line SW
330Ft. From W Line Quarter
 Ist. Report
 Completion MAR 1 6 1955
 Remarks Coppinger - Contr.
 Spudding Date 2-26-55

Drlg. Data D & A TD 3870
8" @ 192 Anhy 1491 Heeb. 3464
Tor. 3485 Lans. 3511 B KC 3758
Marm. 3794 DST 3796-3808 open 1 hr.
Rec. 25' mud 0# Cong. 3814 Gorham
3821 DST 3827-32 open $\frac{1}{2}$ hr. Rec.
15' mud 0# Arb. 3825 DST 3829-40
open $\frac{1}{2}$ hr. Rec. 15' socm 850#
DST 3806-28 open 2 hr. Rec. 5' mud
30# DST 3836-44 open 1 hr. 50 min.
Rec. 5' oil 40' ocm 15' mud 1025#
TD 3870

D & A

FABEN GILSTRAP

County **Ellis** State **Kansas**

Sec. **21** (Blk. **14** (Sur. **19W** Map No.

Operator Colorado Oil & Gas

Well No. **1** Farm, **Kraus "A"**

Elev.	Location	NW	NE	SW
-------	----------	----	----	----

0

FIRST REPORT

330 Ft. From N Line SW

330 Ft. From W Line Quarter

1st. Report FEB 23 1955

Completion

Remarks

Coppinger - Contr.

Spudding Date

Drlg. Data

MIR

FABEN GILSTRAP