

Section 10 Township 34 Range 3E

Well No. #1 Williams

Company Aladdin Pet.

NORTH

SOUTH

WEST

EAST

13

9

Cowley KANSAS

Sec. 10 Twp. 34 R. 3E ✓

Well No. #1 Williams Farm

Aladdin Pet. Company

Crowe - Contr. Contractor

Semi-Wildcat


Ft. from N. Line

330' Ft. from S. Line

Ft. from E. Line

660' Ft. from W. Line

0 S/2 SW SW

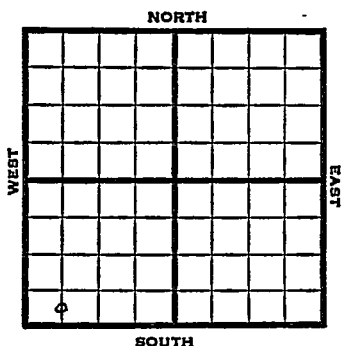

1951 Elev. 1086 REPORT

9/26 Cellar & Pits

11/28 Spud 10-11-51
Oil Well TD 3300
8" @ 93
Top. 1440' Lans. 2106
Stal 2126 KC 2571
Layton 2582
DST 2582-89 opn 45 min. Rec. 62'
gas 2' oil 10' o & gcm 60' sw
Bart 3216 Sand 3252 TD 3300
5" @ 3266 CO to 3300
P/10 bopd Hydro. 5 boph
Comp. 27 bopd

COMPLETED

County Cowley State Kansas

Sec. **10** (Blk. **34** (Sur. **3E** Map No.

Operator **Aladdin Pet.**

Well No. **1** Farm **Williams**

Elev.	Location	C S/2 SW SW

✓

0

✓

FIRST REPORT

330' Ft. From S Line SW

660 Ft. From ~~IV~~ Line Quarter1st. Report **SEP 26 1951**

Completion


Remarks

Crane - Contr.

Spudding Date

Drlg. Data Semi Wildcat.

Cellar & pits

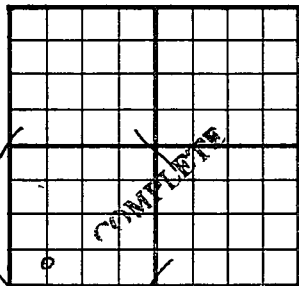County Cowley State KansasSec. 10 (Blk.) 34 (Sur.) 3E Map No.Operator Aladdin Pet.Well No. 1 Farm WilliamsElev. 1086 Location C S L SW SW330 Ft. From S Line SW660 Ft. From W Line Quarter

1st. Report

Completion NOV 28 1951Remarks Semi WildcatCrowe Drlg. - Contr.Spudding Date 10-11-51Drlg. Data Oil well TD 33008" @ 93 Top. 1440 Lans. 2106Stal. 2126 KC 2571 Layton 2582DST 2582-89 open 45 min. Rec. 62' gas2' oil 10' o & gcm 60' swBart. 3216 sand 3252 TD 3300 5" @ 3266CO to 3300 P/ 10 bopd Hydro.5 bopd Comp. 27 bopd

J. E. TYRA