


Section 23 Township 29 Range 5E

Well No. 9 Corbett

Company H. H. Blair

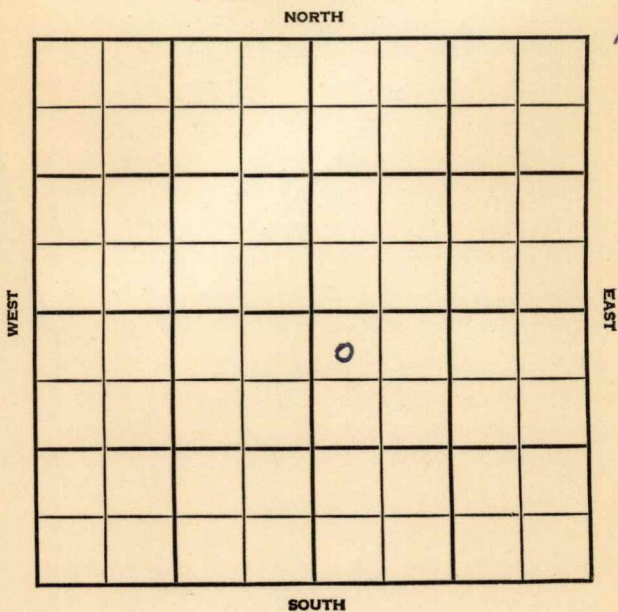

Butler KANSAS


SEC.	TWP.	R.
23	29	5E

WELL NO. **9 Corbett** FARM

COMPANY **H. H. Blair**

CONTRACTOR **Krisswell  
Fox-Bush Pool**

330 Ft. from N. Line  
 \_\_\_\_\_ Ft. from S. Line  
 \_\_\_\_\_ Ft. from E. Line  
330 Ft. from W. Line

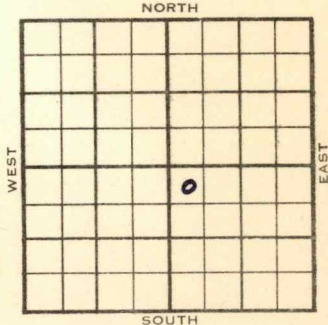

NW NW SE

1954	ELEVATION	REPORT
------	-----------	--------

11/17  
 1955  
 1/26

Drlg. 2180'  
 Temp. Abd. TD 2809' **KC 2170**  
**Bart 2766** TD 2809 5" @ 2785  
 CO to 2809 PB 2802 frac.'  
 Temp. abd.

**ABANDONED**



