

Ellis


KANSAS

SECTION 21 TOWNSHIP 14 RANGE 19W

WELL NO. #1 Esther M. Kraus

COMPANY Tenn. Gas Trans. Co.

NORTH

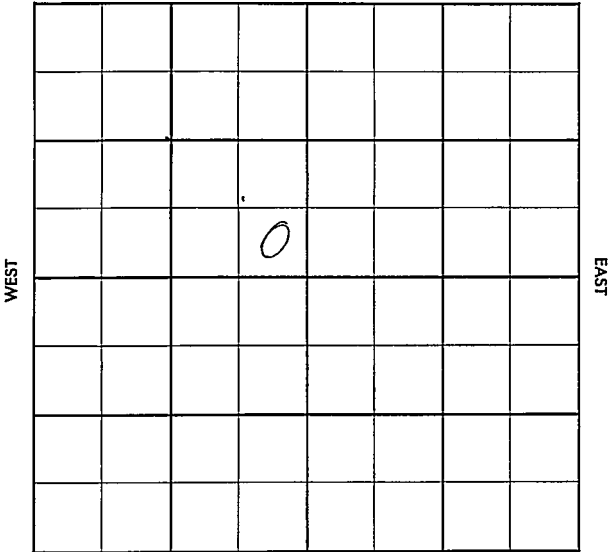

SOUTH

County ELLIS Elev. _____
 Sec. 21 Twp. 14 Rgs. 19W
 Company Tenn. Gas Trans. Co.
 FarmName Esther M. Kraus No. 1

TOPS	DEPTH	LOG	DATUM	Loc. in Sec.
Anh.				SE SE NW
TP.				
H.				
Tr.				
Dg.				
BL.				
L.				
K.C.				Geol.
B.K.C.				Contr.
Ce.				Shelley-Mille
C.				Tools
M.				Pool
M.				Kraus
K.				
Mz.				
Me.				
V.				
S.				
S.				
A.				
R.				
Pe.				
G.				
TD.				

FIRST REPORT

Date Comm. 10-5-56

8" @ 261 w/250, Drlg. 2950 OCT 10 '56

G.A.

Co.

County Elm Elev. 2149
 Sec. 21 Twp. 14 Rge. 19W
 Company Tenn. Gas Trans. Co.
 Farm Name Esther M. Kraus No. 1

TOPS	DEPTH	LOG	DATUM	Loc. in Sec.
Anh.				SE SE NW
Tr.				
H.	3400			
Tr.	3419			
Dg.				
BL.				
L.	3444			Geol.
K.C.				Contr.
BKG.	3692			Shelley-Miller
Ce.				Tools
C.	3750			Pool
M.				Kraus
M.				
K.				
Mz.				
Mo.				
V.				
S.				
S.				
A.	3774			
R.				
Pe.				
G.				
TR.	3777			

Lsg.

No.

Sec.

T.

R.

Date Comm. 10-5-56

8" @ 261 w/250, Drlg. 2950 Oct 17 '56

DST 3453-3520 1hr 454' MSW

PP 125-400 BHP 1075/20"

DST 3748-73 1hr 10' 50 CM

BHP 165 DST OCT 24 '56 3774-77

CR 90" 80' 900' + 400' HOCM

BHP 1000/30 5 1/2 @ 3775 MICT

CO 3777 @ 26 BO in 18 hrs 1/10

@ 26 BO in 2 hrs POP OCT 31 '56 NOV 7 '56

NOV 13 '56

NOV 21 '56

Ph.P. 97 Bopp + 7/1041% WWS