


Section 31 Township 18 Range 6W

Well No. 1 Deal "B"

Company Bridgeport Oil

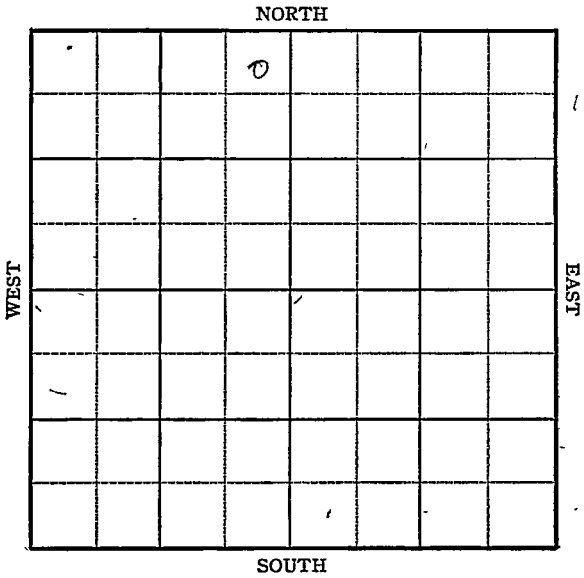

Sec. 31 Twp. 18 R. 6-W

Well No. #1 Deal "B" Farm


Bridgeport Oil Company

330 Ft. from N. Line

_____ Ft. from S. Line

330 Ft. from E. Line

_____ Ft. from W. Line

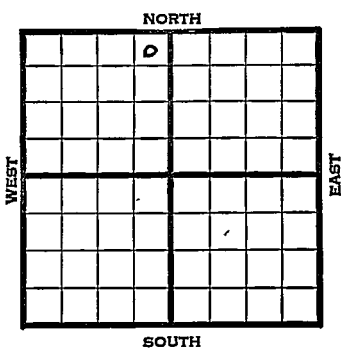

NE NW

1945

REPORT

Elev. 1611

8/8

8" @ 177' WOC

8/15

Heebner 2524

Lans. 2715

BKC 3066

Drlg. 3090'

8/22

Viola 3351

Simp. 3394

Arb. 3454

TD 3508'

ABANDONED

KANSAS
Kansas

Pool Name Wildcat

Map No. 44 Sec. 31 Twp. 18 R. 6W

Well No. 1 Deal "B"

Bridgeport Oil Company

FIRST REPORT

Contractor

NE NW

SECTION PLAT

330 Ft. from N. Line

_____ Ft. from S. Line

330 Ft. from E. Line

_____ Ft. from W. Line

	0		

Rice County

Location _____

Rig up _____

Drilling and Remarks:

8"-177 WOC

RECORD

Cased _____ in., _____ ft.

Sand _____

Gas _____

Oil _____

Total Depth _____

PRODUCTION

1st 24 hrs. Nat. _____

1st 24 hrs. after shot _____

Gas _____ Cu-Ft.

Dry Hole _____

Abandoned _____

Date

AUG 8 1945 19

S. J. LEWIS

Scout

Pool Name Wildcat
 Kansas
 Map No. 77 Sec. 31 Twp. 18 R. 6W
 Well No. 1 Deal "B"

Bridgeport Oil Company

ABANDONED

Contractor

NE NW

E 1/6 1/1
SECTION PLAT

330 Ft. from N. Line

_____ Ft. from S. Line

330 Ft. from E. Line

_____ Ft. from W. Line

		0	

Rice County

Location _____

Rig up _____

Drilling and Remarks:

Vita 3351
Smf 3394
Cr 3457

RECORD

Cased _____ in., _____ ft.

Sand _____

Gas _____

Oil _____

Total Depth 2508

PRODUCTION

1st 24 hrs. Nat. _____

1st 24 hrs. after shot _____

Gas _____ Cu. Ft.

Dry Hole _____

Abandoned _____

Date

AUG 22 1945 19

S. J. LEWIS Scout