

KANSAS Rice

Section 32 Township 18 Range 6W

Well No. 1 Hoffman

Company Atlantic

Wildcat
NORTH

						0	

WEST

EAST

SOUTH

Rice

Sec. 32 Twp. 18 R. 6W

Well No. #1 Hoffman Farm

Atlantic

Wildcat (Lohman & Johnson, Cont.) Company


330' Ft. from N. Line

_____ Ft. from S. Line

990' Ft. from E. Line

_____ Ft. from W. Line

NW NE NE

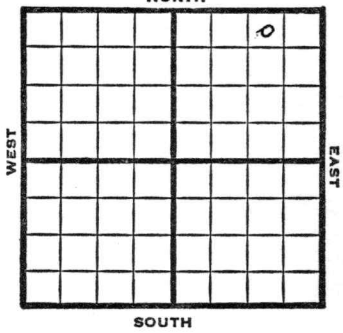

1949

Elev 1667'

REPORT

8/3	Location
8/10	"
8/17	10" @ 284' Lansing 2747' Drlg 2787'
8/24	Viola 3472' Simpson 3512' Arbuckle 3578' TD 3600-7" @ 3600'
8/31	"
9/7	500 acid
9/14	Pump 104 bbls oil 24 hrs. 29 ³ Gravity
9/21	"
9/28	"
10/5	"
10/12	TD 3600' Lans 2747' Arb. 3578' 7" @ 3600' Perf Lans 650 acid Pump 330 Oil Pot 29 ⁹ Gr Comp

COMPLETED

Kansas


Wildcat

Map No. _____ Sec. 32 Twp. 18 R. 6WWell No. 1 Hoffman_____
Atlantic _____ Company

Lohman & Johnson

Contractor

NW NE NE

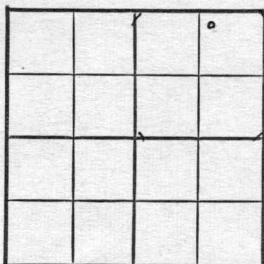FIRST REPORT
SECTION PLAT_____
330 Ft. from N. Line_____
Ft. from S. Line_____
990 Ft. from E. Line_____
Ft. from W. Line

Rice County

Location ✓

Rig up _____

Drilling and Remarks:

RECORD

Cased _____ in., _____ ft.

Sand _____

Gas _____

Oil _____

Total Depth _____

PRODUCTION

1st 24 hrs. Nat. _____

1st 24 hrs. after shot _____

Gas _____ Cu. Ft.

Dry Hole _____

Abandoned _____

Date

AUG 3

1949

19

S. J. LEWIS

Scout

Map No. _____ Sec. 32 Twp. 18 R. 6W

Well No. 1 Hoffman

Atlantic Company

COMPLETE

Contractor

NW NE NE

E 11667

SECTION PLAT

330 Ft. from N. Line

_____ Ft. from S. Line

990 Ft. from E. Line

_____ Ft. from W. Line

Rice County

RECORD

Location _____

Cased _____ in., _____ ft.

Rig up _____

Sand _____

Drilling and Remarks:

Gas _____

Oil _____

Total Depth 3600

PRODUCTION

1st 24 hrs. Nat. _____

1st 24 hrs. after shot _____

Gas _____ Cu. Ft.

Dry Hole _____

Abandoned _____

Lease 2747
Acx 3578
2" @ 3600
Perf lease
650 acres
Prog 330 oil Prod
299

Date

OCT 12 1949 19

S. J. LEWIS Scout