


Section 11 Township 34 Range 3 E

Well No. # 1 Hunt

Company Aladdin Pet.

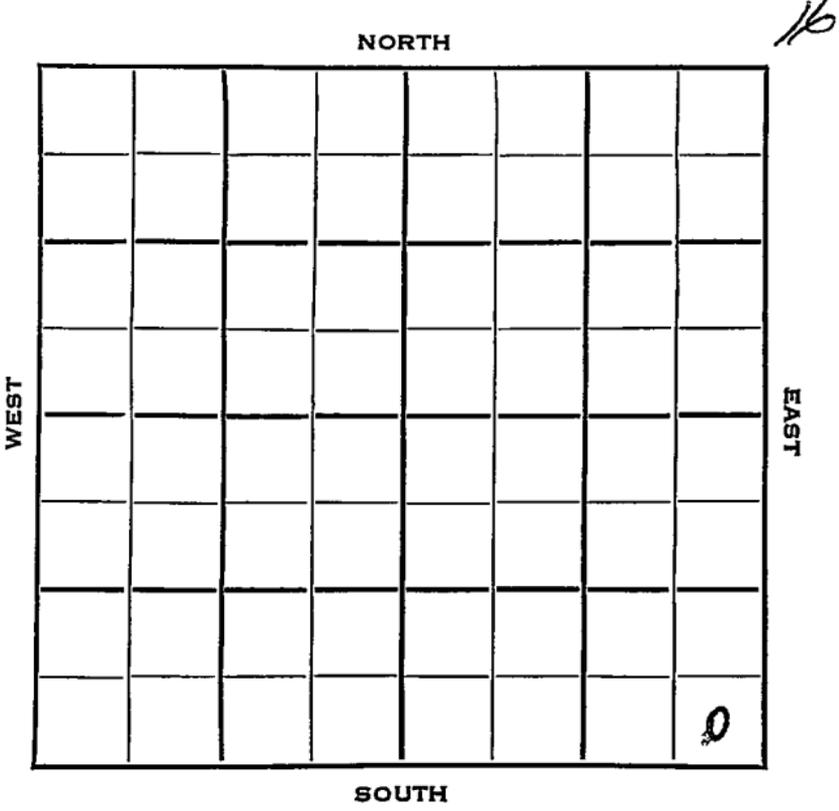

Sec. 11 Twp. 34 R. 3E

Well No. #1 Hunt Farm

Aladdin Petr. Company

Contractor

E. Baird Pool


         Ft. from N. Line

330 Ft. from S. Line

330 Ft. from E. Line

         Ft. from W. Line

SE SE SE

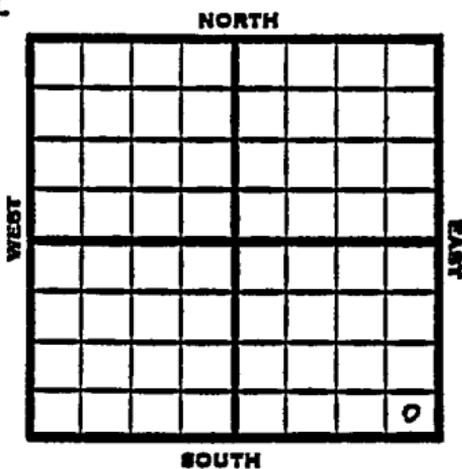

1952 Elev. 1156' REPORT

12/3 Location

4/15 Spud 12-10-52

D & A

TD 3410'

8" @ 125'

Severy Sd 1400, Bart 3375,

TD 3395

5" @ 3376

CO to 3395

PB 3393 Hydro. wtr. DD 3400

DD 3410 PB 3370 24/ 2856-60 dry

D & A

**ABANDONED**

County **Cowley** State **Kansas**

Sec. **11** (Blk.) **34** (Sur.) **3E** Map No. (Twp.) (Rge.)

Operator **Aladdin Pet.**

Well No. **1** Farm **Hunt**

Elev. Location **SE SE SE**


**FIRST REPORT**

**330** Ft. From **S** Line **SE**

**330** Ft. From **E** Line Quarter

Ist. Report **DEC 3 1952**

Completion

Remarks

Spudding Date

Drlg. Data **E. Baird Fool**

**Location**

