

Ellis


KANSAS

SECTION 21 TOWNSHIP 14 RANGE 19W

WELL NO. #1 Kraus

COMPANY Petroleum Inc.

NORTH

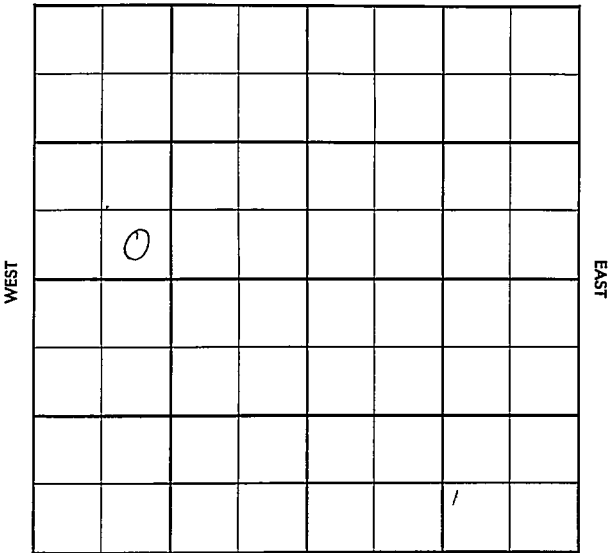

SOUTH

County Ellis Elev. _____
 Sec. 21 Twp. 14 Rge. 19W
 Company Petroleum Inc.
 Farm Name Kraus No. 1

TOPS	DEPTH	LOG	DATUM	Loc. in Sec.
Anh.				SE SW NW
Tr.				
H.				
Tr.				
Dg.				
Bl.				
L.				Geol.
K.C.				Contr.
B.K.C.				Garvey Tools
Ce.				Pool
C.				Kraus No.
M.				
M.				
K.				
Mz.				
Me.				
V.				
S.				
S.				
A.				
R.				
PE.				
G.				
T.D.				

Date Comm.

MIRT

~~14~~

DEC 19 56

County Elvis Elev. 2204
 Sec. 21 Twp. 14 Rge. 19E
 Company Petroleum Inc.
 Farm Name Kraus No. 1

TOPS	DEPTH	LOG	DATUM	Loc. in Sec.
Anh.				SL SW N.
Tp.				
H.	3459			
Tr.	3479			
Dg.	3494			
Bl.				
L.	3505			
K.C.				Geol.
BKG.				Gantr.
Ce.				Garvey Tools
C.				
M.				Pool
M.				Kraus No.
K.				
Mz.				
Ma.				
V.				
S.				
S.				
A	3827			
R.				
PE				
G.				
TD	3843			

ABANDONED
 JAN 30 '57

Date Comm.

MIRT DEC 20 '56 12-18-56 85/8

222/155 17 3530 JAN 2 '57

DST 3809-25 cor 1 hr sec 15' md
 BHP 0/20" DST 3827-32 cor
 1 hr sec 65' HOCM BHP 1025/20"
 DST 3850-36 1 hr sec 80' HOCM
 BHP 1040/20" DST 3836-43
 cor 1 hr sec 45' SGC M BHP 1020
 120" no log 5 1/2 3827/50

JAN 9 '57

CO 3843 \$ 36

Goph 490 wtr 3 hrs \$

3 1/2 BFph 1290 wtr 14 hrs

PB 3836 13/4 \$ 6 BFph

85% wtr 11 hrs 1350' Q.B

~~P.B.~~

JAN 15 '57

JAN 21 '57

JAN 27 '57

pumping 95% wtr

D & W

21-14-19

see also mnd