


Section 23 Township 29 Range 5E
Well No. 10 Corbett
Company H. H. Blair

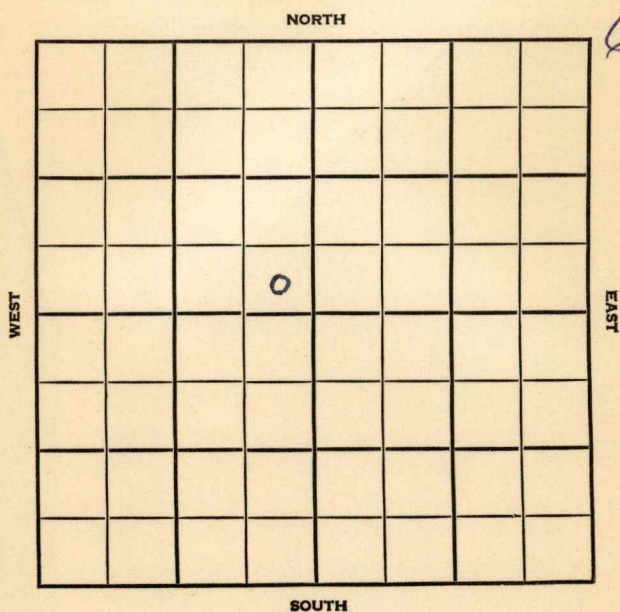

Butler KANSAS

SEC.	TWP.	R.
23	29	5E

WELL NO.

10 Corbett

FARM

COMPANY

H. H. Blair

CONTRACTOR


~~XX~~ Fox-Bush Pool

_____ Ft. from N. Line

330 _____ Ft. from S. Line

330 _____ Ft. from E. Line

_____ Ft. from W. Line

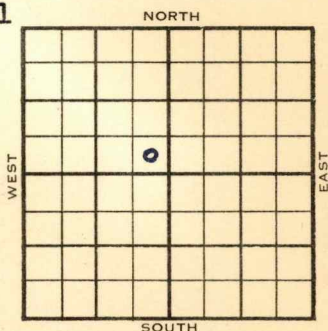

SE SE NW

ELEVATION

REPORT

1954

1343'

11/17

Location

1955

1/19

Spud 12-28-54 Oil well TD 2832
8" @ 86 KC 2169DST 2170-90 open 1 hr rec 7' OCM
28# Bart. 2767 Miss 2831 TD 2832

CO to 2789 48/2768-76 frac.

S/15 BO 8 BW Comp. 25 BOPD

COMPLETED

FABEN GILSTRAP

County Butler State Kansas
 Sec. 23 (Blk.
Twp.) 29 (Sur.
Rge.) 5E Map No.
 Operator H. H. Blair
 Well No. 10 Farm Corbett
 Elev. 1343 Location SE SE NW

330 Ft. From S Line NW

330 Ft. From E Line Quarter

1st. Report

Completion JAN 1 9 1955

Remarks Fox-Bush Pool

Spudding Date 12-28-54

Drlg. Data Oil well TD 2832
8" @ 86 KC 2169 DST 2170-90 open 1 hr.
Rec. 7' ocm 28# Bart. 2767 Miss. 2831
TD 2832 CO to 2789 48/ 2768-76
frac S/ 15 bo 8 bw
Comp. 25 bopd

FABEN GILSTRAP