


Section **23** Township **29** Range **5E**

Well No. **#6 Corbett**

Company **H. H. Blair**

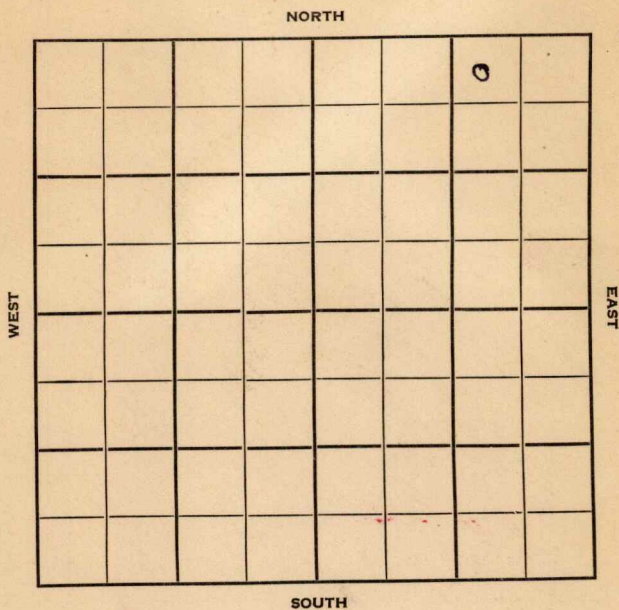



Sec. 23 Twp. 29 R. 5 E

Well No. # 6 Corbett Farm

H. H. Blair Company

Watson Contractor


330 Ft. from N. Line

 Ft. from S. Line

990 Ft. from E. Line

 Ft. from W. Line

NW NE NE

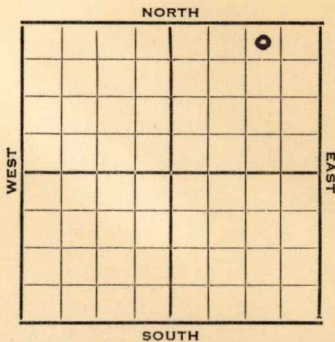

1952

Elev. 1362' REPORT

9/17

8" @ 86'

10/5

Spud 9-26-52

Oil Well TD 2836' 8" @ 86

Bart. 2770

TD 2836 5" @ 2832 CO to 2836

15 bopd 55 A Sd-Frac

Comp. 25 bopd

COMPLETED

J. G. McGEHEE

J. G. McGEHEE