


DX 78-1

Rice KANSAS

Section 32 Township 18 Range 6W

Well No. 1 Bendure

Company Frontier Oil

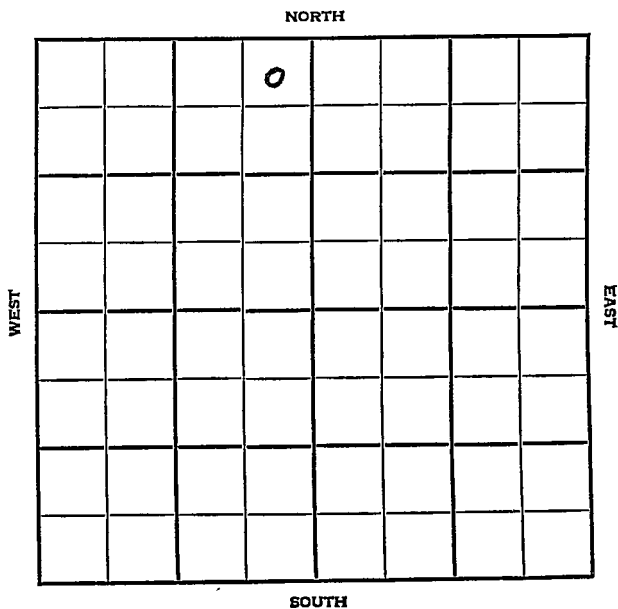

Rice KANSAS


SEC.	TWP.	R.
32	18	6W

WELL NO. **1 Bendure** FARM

COMPANY **Frontier Oil**

CONTRACTOR

Wil cat
330 Ft. from N. Line
 _____ Ft. from S. Line
330 Ft. from E. Line
 _____ Ft. from W. Line

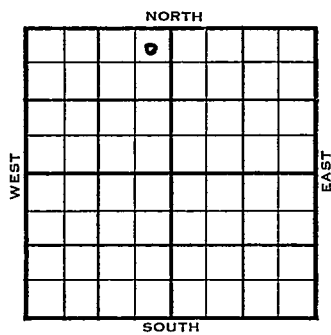

NE NE NW

1955	ELEVATION 1669'	REPORT
------	---------------------------	--------

2/2

Location

4/6

Spud 3-22-55, D&A, TD 3221
 8" @ 180, Heeb 2577, Br Lime
 2716, Lans 2755, DST 3084-3117
 open 1 hr. Rec. 15' mud 0#
 Cong. 3199, TD 3221
 D&A

ABANDONED

