


Butler

KANSAS

SECTION 23 TOWNSHIP 29S RANGE 5E

WELL NO. #16 Corbett

COMPANY H.H. Blair

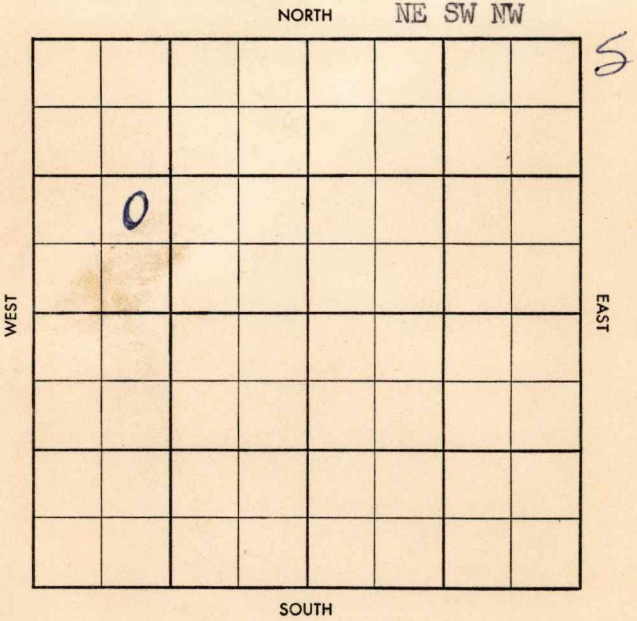

FIRST REPORT

CO. Butler ELEV. _____

SEC. 23 TWP. 29 RGE. 5E

COMPANY H. H. Blair NO. 16

| | |
|-------------|--|
| NOV 20 1957 | |
| | |
| | |
| | |

FARM Corbett

LOC. NE SW NW

| | |
|--|--|
| | |
| | |
| | |
| | |
| | |
| | |
| | |
| | |
| | |
| | |

GEOL. _____

CONTR. Wakefield Drlg. #1

POOL Fox-Bush

SPUD _____

Loc. _____

CO.

LSE.

NO.

SEC.

TWP.

RGE.

29