


DX 78-1

Section 23 Township 29 Range 50

Well No. 3 Lewis

Company H. H. Blair

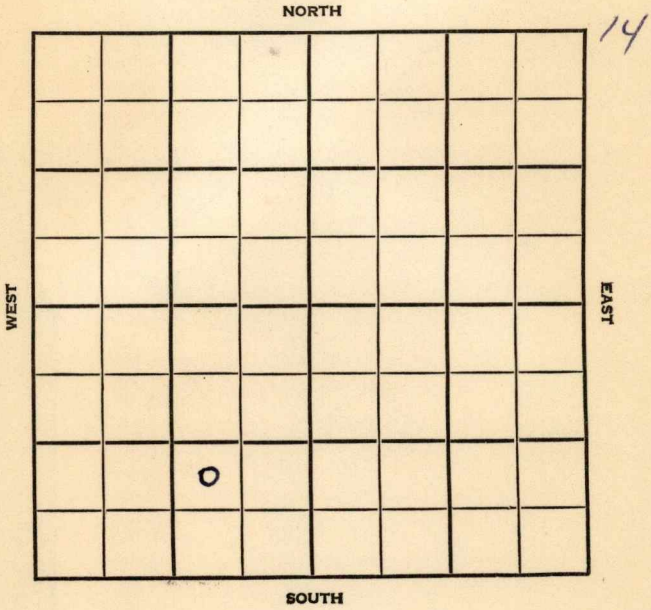

Butler KANSAS

SEC.	TWP.	R.
23	29	5E

WELL NO. 3 Lewis FARM

COMPANY H. H. Blair

CONTRACTOR Criswell


Fox-Bush Pool

_____ Ft. from N. Line

990 _____ Ft. from S. Line

990 _____ Ft. from E. Line

_____ Ft. from W. Line

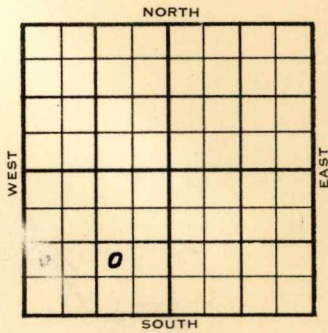

NW SE SW

1954	ELEVATION 1330'	REPORT
------	--------------------	--------

6/30 surface set
 9/1 Spud 8-5-54 - Oil Well
 TD 2794'
 8" @ 86'
 KC 2153', Bart. 2751'
 TD 2794'
 5" @ 2766'
 CO to 2794'
 Sd-frac
 C omp. 25 bopd 100 bw

COMPLETED

