


Section 32 Township 18 Range 6 W

Well No. # 1 Sims

Company L. B. Jackson, Jr.

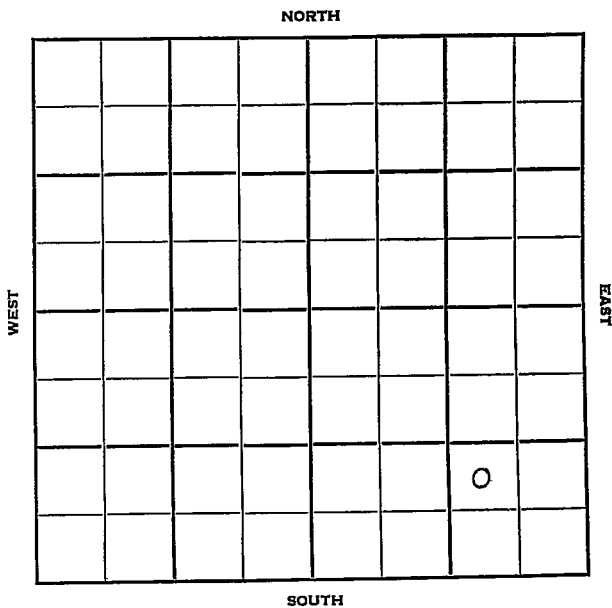

Rice

KANSAS ✓

Sec. 32 Twp. 18 R. 6 W

Well No. # 1 Sims Farm

L. B. Jackson Jr. Company

Jackson Contractor


Wildcat

\_\_\_\_\_ Ft. from N. Line

990 Ft. from S. Line

990 Ft. from E. Line

\_\_\_\_\_ Ft. from W. Line

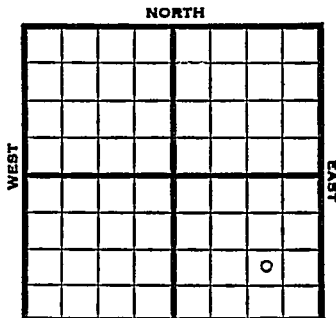

NW SE SE

Deep Rock Farmout - Atlantic Drilling

1951 Elev. 1646' REPORT

5/2 Spud 4-26-51  
8" @ 170  
Drlg. 1800'

6/20 Spud 4-26-51  
Oil Well TD 3145  
8" @ 170  
Anhy 935  
Lans. 2740  
DST 3067-92 opn 1 hr Rec. 25' oil  
35' ocm TD 3145  
5" @ 3142 54/2995-3005  
S/1 boph 1000 A Comp. 2 bo 12 bwpd

**COMPLETED**



