


SEC. 23	TWP. 29	R. 5E
------------	------------	----------

WELL NO. #6 Lewis FARM

COMPANY H.H. Blair

CONTRACTOR Nriswell

_____ Ft. from N. Line
 _____ Ft. from S. Line
 _____ Ft. from E. Line
 _____ Ft. from W. Line

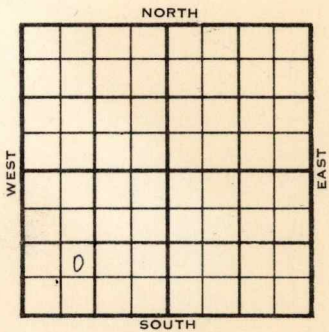

NE SW SW

	ELEVATION	REPORT
1956		

1-25 Comm. 1-20-56
 8 5/8" @ 95/75
 Drlg. 2435

 Sec: 23 Twp: 29 Rge: 5E
 Company: H. H. Blair
 Farm Name: Lewis No. 6

	TOPS	DEPTH	LOG	DATUM	Loc. in Sec.
Ant.					NE SW SW
Tp.	Birth	2780		1455	
H.					
Tn.					
Dp.					
Bl.					
L.					Loc.
R.C.					Cont.
Bulk.					Kriswell
Co.					
C.					
M.					
M.					
M.					
M.					
M.					
V.					
S.					
S.					
A.					
R.					
P.					
B.					
SP		2801			

COMPLETE

Date Comm. 1-20-56 FEB 22 1956
 8 5/8" @ 95/75 orig. 2435 FEB 1 56

Ord 2761-2801 sd from 2782-2801
 5 1/2" 2800 / FEB 10 56 FEB 16 56 FEB 22 56
 2792 48 / 2782-90 frac
 Lost Lead

complete water on put well
 200 I MAY
 20 56

County Butler Elev. _____
 Sec. 23 Twp. 29 Rge. 5E
 Company H. H. Blain
 Farm Name Lewis No. 6

TOPS	DEPTH	LOG	DATUM	Loc. in Sec.
Anh.				NE SW SW
TP.				
H.				
Tr.				
Dg.				
BL.				
L.				Geol. _____
K.C.				Contr. _____
B.K.C.				<u>Kriswell</u>
Ce.				
C.				Pool _____
M.				
M.				
K.				
Mz.				
Mo.				
V.				
S.				
S.				
A.				
R.				
PE.				
G.				
T.D.				

FIRST REPORT
 JAN 25 1956

Date Comm. 1-20-56
8 5/8" @ 95/75 drlg. 2435

Co.
 Lse.
 No.
 Sec.
 T.