


Section 32 Township 18 Range 6W

Well No. #1 Simms

Company Gilbert Bridges

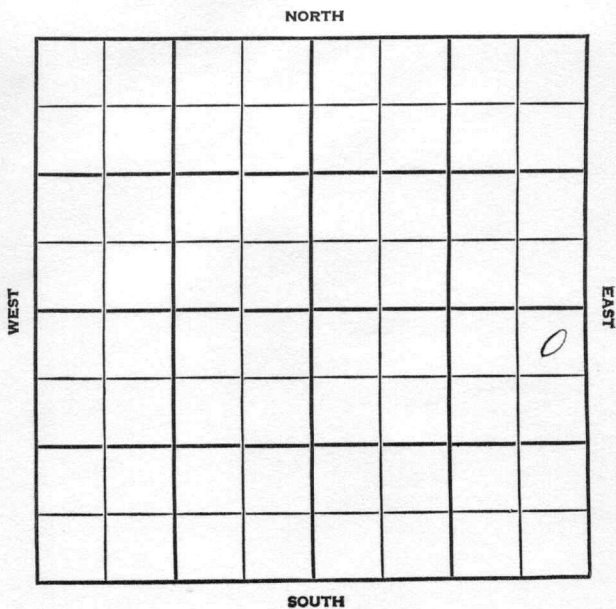

County Rice Elev. 1651 DF
 Sec. 32 Twp. 18 Rge. 6W
 Company Gilbert Bridges
 Farm Name Simms No. 1

TOPS	DEPTH	LOG	DATUM
Anh.			
TP.			
H.	2569		
Tr.	2588		
Dg.	2601		
Bl.	2712		
L.	2744		
K.C.			
B.K.C.			
Ce.			
C.			
M.			
M.			
K.			
Mz.			
Ma.			
V.			
S.			
S.			
A.			
R.			
PE.			
G.			
TD.	3089		

Loc. in Sec. NE NE SE

Geol. _____
 Contr. Salina Drlg.

Pool Odessa

NOV 4 1956	
0	
FIRST REPORT	

Date Comm. 11-1-56
5" @ 3087/75 8" @ 180/130

LR

Co. No. Sec. T. R.

County Rice Elev. 1351 DF
 Sec. 32 Twp. 18 Rge. 6W
 Company Gilbert Bridges
 Farm Name Simms No. 1

TOPS	DEPTH	LOG	DATUM
Anh.			
Tp.			
H.	2569		
Tr.	2588		
Dg.	2601		
Bl.	2712		
L.	2717		
K.C.			
B.K.C.			
Ce.			
C.			
M.			
M.			
K.			
Mz.			
Me.			
V.			
S.			
S.			
A.			
R.			
PE.			
G.			
T.D.	3089		

Loc. in Sec. NE NE SE
 Geol. _____
 Contr. Salina Drlg.
 Pool _____
Odessa

NOV 23 56
COMPLETE

Date Comm. 11-1-56

5" @ 3087/75 8" @ 180/130 NOV 21 '56 CO

3089 1/2 FU 600 oil n/w

12 hrs P. 20 BOPD + 5 BWPd

Co.

Lse.

No.

Sec.

T.

R.