


Map No. **KANSAS** Sec. 17 Twp. 14 R. 19w
Well No. 1-Trans Farm
Herby & Empire Company

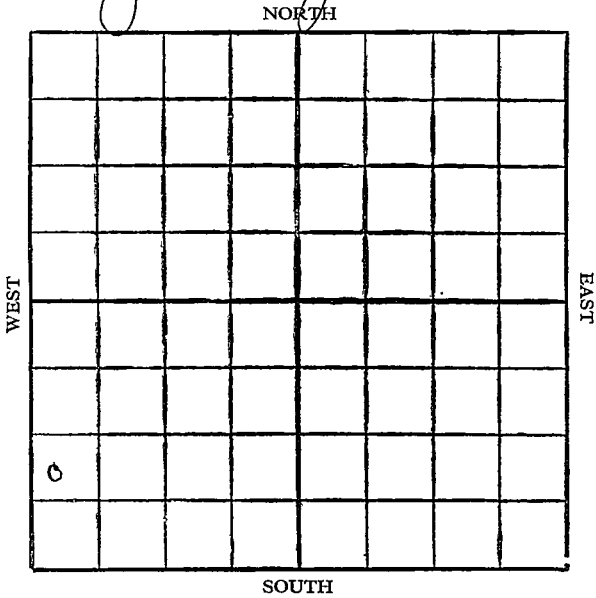

Location

Drilling Remarks

.....

.....

RECORD

Cased.....in.ft.

Sand

Gas

Oil

Total Depth.....

Rig Up.....

Drilling Remarks

.....

.....

PRODUCTION

1st 24 hrs. Nat.

1st 24 hrs. after shot.....

Gas..... cu. ft.

Dry Hole.....


Abandoned

Map No. KANSAS Sec. 17 Twp. 14 R. 19WWell No. 1-Kraus FarmHerby & Empire Company

Ft. from N. Line

990 Ft. from S. Line

Ft. from E. Line

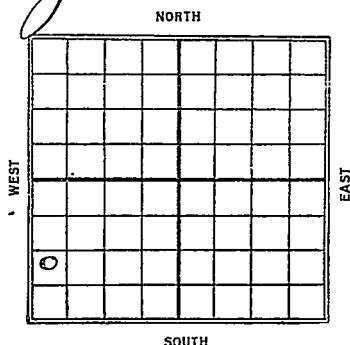300 Ft. from W. Line1928

Date	REPORT
5/23	R.O.G.
5/31	Reg
6/6	Spud
6/13	Spud - S.D.
6/20	
6/27	T.D. 50 - S.D.
7/3	Spud 90'
7/10	Drilg 110'
7/18	T.D. 1600 - fsg pipe -
7/25	Shut down
8/1	Drilg 975'
8/7	" 1345'
8/15	" 1480'
8/22	" 1800'
9/5	T.D. 2660 2 1/2" 8"
9/12	
9/19	Drilg 2845'
9/26	" 2960'
10/3	S.D. - 2960' - T.D.
10/10	T.D. 2960 - Cement case
10/17	
10/24	Drilg 3075'

Elles
 MAP NO. 17 SEC. 17 TWP. 14 R. 19 W

No map
 WELL NO. Trans

Herty Oil & Empire Oil Ref. COMPANY

CONTRACTOR

SECTION PLAT

0			

_____ FT. FROM N. LINE

990 FT. FROM S. LINE

_____ FT. FROM E. LINE

300 FT. FROM W. LINE

ABANDONED

LOCATION _____

RIG UP _____

DRILLING AND REMARKS:

X.F. 3880

TXA

RECORD

CASED _____ IN. _____ FT.

SAND _____

GAS _____

OIL _____

TOTAL DEPTH 3881

PRODUCTION

1ST 24 HRS. NAT. _____

1ST 24 HRS. AFTER SHOT _____

GAS _____ CU. FT.

DRY HOLE _____

ABANDONED _____

DATE

1929 1929

S. J. LEWIS SCOUT

Map No. KANSAS Sec. 17 Twp. 14 R. 19W

Well No. 1 Kians

Derby Oil & Empire Oil Ref. Company
Contractor

SECTION PLAT

-----Ft. from N. Line

990 Ft. from S. Line

-----Ft. from E. Line

300 Ft. from W. Line

0			

FIRST REPORTS

Location -----

Rig up -----

Drilling and Remarks:

ROG

RECORD

Cased ----- in., ----- ft.

Sand -----

Gas -----

Oil -----

Total Depth -----

PRODUCTION

1st 24 hrs. Nat. -----

1st 24 hrs. after shot -----

Gas ----- Cu. Ft.

Dry Hole -----

Abandoned -----

Date

MAY 23 1928

S. J. LEWIS

Scout

10/31- No report
11/7- Drly 3255'
11/14- TD 3255' log bailed
11/21- Drly 3483'
11/28- Top Oswald 3529'
12/5- Drly 3603'
12/12- " 3660'
12/19- TD. 3829-
100' oil hole - V/R 5"

12/26 —

1929

1/2 —

1/9 —

1/16 —

1/23 —

1/30 —

2/6 —

2/13- T.D. 3860' = 1100' oil

2/20- HFW- 3880'

T.D. 3881'

dry & abandon