


Map No. _____ Sec. 24 Twp. 29 R. 5
 Well No. 1 Bush Farm
Gypsy & Buser Company
 NORTH

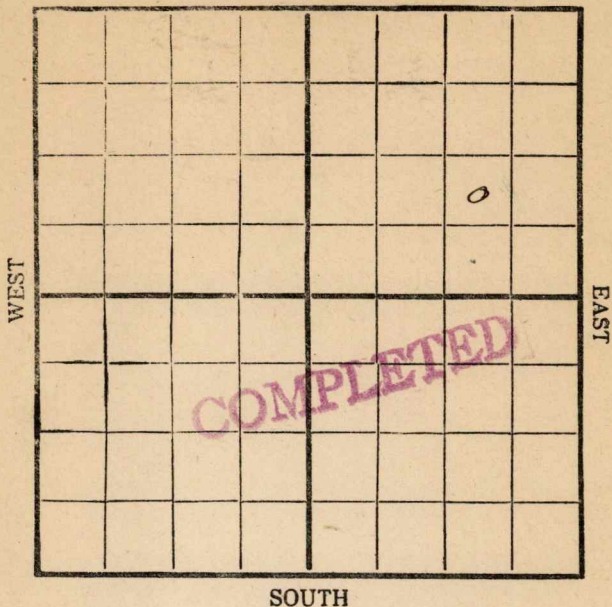

Location _____

Rig Up _____

Drilling Remarks:

Drilling Remarks:

RECORD

Cased _____ in. _____ ft.

Sand _____

Gas _____

Oil _____

Total Depth _____

PRODUCTION

1st 24 hrs. Nat. _____

1st 24 hrs. after shot _____

Gas _____ cu. ft.

Dry Hole _____

Abandoned _____

Map No. _____ Sec. 24 Twp. 29 R. 5

Well No. 1. Bush Farm _____

Gypsy & Busch Company _____

Contractor _____


ME Quarter

_____ Ft. from N. Line

990 Ft. from S. Line

990 Ft. from E. Line

_____ Ft. from W. Line

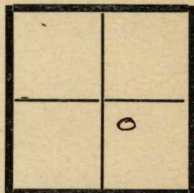

Date	REPORT
11/10	Location
11/11	Location
11/17/20	Location
23	"
29	✓
2/2	✓
11	Rig
24	Rig moved to Section 25'
	Location abundant

COPY FILED


Map No. K 11 Sec. 24 Twp. 29 R. 5Well No. 1 BushTypos & Busch Company

Contractor

NORTH

WEST

EAST

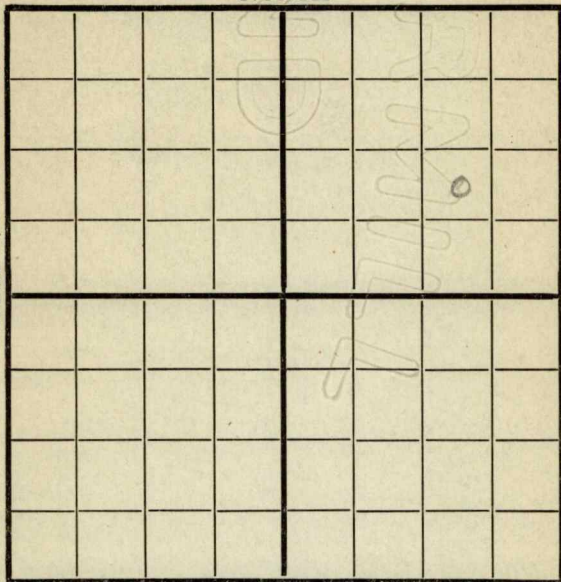

SOUTH

990 S-ELocation ✓

Rig up

Drilling and Remarks:

RECORD

Cased _____ in., _____ ft.

Sand _____

Gas _____

Oil _____

Total Depth _____

PRODUCTION

1st 24 hrs. Nat. _____

1st 24 hrs. after shot _____

Gas _____ Cu. Ft.

Dry Hole _____

Abandoned _____

Date

7/21 1919 Pyle Scout

Map No. K11 Sec. 24 Twp. 29 R. 5Well No. 1 BushGypsy Oil Company

Contractor

SECTION PLAT

Ft. from N. Line

Ft. from S. Line

Ft. from E. Line

Ft. from W. Line

			0

Location

Rig up

Drilling and Remarks:

RECORD

Cased _____ in., _____ ft.

Sand _____

Gas _____

Oil _____

Total Depth _____

PRODUCTION

1st 24 hrs. Nat. _____

1st 24 hrs. after shot _____

Gas _____ Cu. Ft.

Dry Hole _____

Abandoned _____

Date

2/24 1912

Pyle

Scout