

Section 33 Township 18 Range 6W

Well No. #2 Johanson

Company L. B. Jackson

NORTH

		G					

WEST

EAST

SOUTH

Rice

KANSAS
6 W

Sec. 33 Twp. 18 R. 6 W

Well No. # 2 Johanson Farm

L. B. Jackson Company

Contractor

Odessa


330 Ft. from N. Line

Ft. from S. Line

990 Ft. from E. Line

Ft. from W. Line

NW NE NW

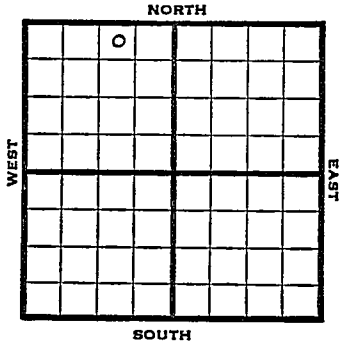

1951

Elev. 1679' REPORT

10/17

Spud 10-1-51
 8" @ 185'
 Heeb 2585', Br L. 2725', Lans 2757'
 DST 3115-31, 1 hr, 30' SOGM
 DST 3096-3131' 2 hrs., 40' OCM
 TD 3200' 5" @ 3170'

11/14

Spud 10-1-51
 Oil well TD 3200' 8" @ 185'
 Heeb 2585' Br. lime 2725'
 Lans. 2757'
 DST 3115-31 open 1 hr. rec 30' SOGM
 DST 3115-31 open 1 hr. rec 30' SOGM
 DST 3096-3131 open 2 hr. rec 40' OCM
 TD 3200' 5" @ 3170 45/3121-29
 3 GOPH 250 A 2 1/4 BOPH
 2000 A S/5 BOPH
 Comp. 35 BOPD

COMPLETED

County Rice State Kansas
 Sec. 33 (Blk.) 18 (Sur.) 6W Map No.
 Operator L. B. Jackson
 Well No. 2 Farm Johanson
 Elev. 1679 Location NW NE NW

330 Ft. From N Line NW990 Ft. From E Line Quarter

Ist. Report

Completion NOV 14 1951Remarks Odessa PoolSpudding Date 10-1-51

Drlg. Data Oil well TD 3200
8" @ 185 Heeb. 2585 Br. lime 2725
Lans. 2757 DST 3115-31 open 1 hr.
Rec. 30' socm DST 3096-3131 open 2 hr.
Rec. 40' ocm TD 3200 5" @ 3170
45/ 3121-29 3 goph 250 A 2 $\frac{1}{4}$ boph
2000 A S/ 5 boph Comp. 35 bopd

J. E. TYRA