


Section 23 Township 29 Range 5E

Well No. 2 Lewis

Company H. H. Blair

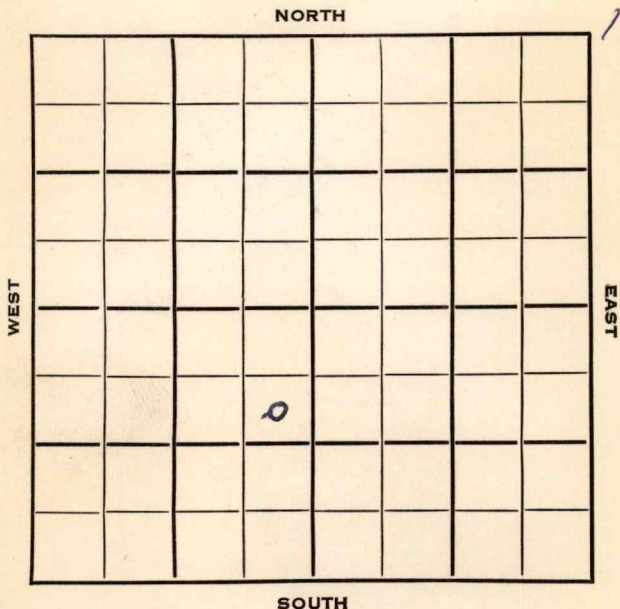

Butler

KANSAS

SEC.	TWP.	R.
23	29	5 E

WELL NO. # 2 Lewis FARM

COMPANY H. H. Blair

CONTRACTOR

Fox Bush Pool


990 Ft. from N. Line

Ft. from S. Line

330 Ft. from E. Line

Ft. from W. Line

SE NE SW

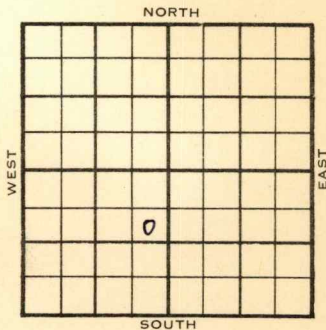

ELEVATION	REPORT
1954	

3/3 Location

6/2 Spudding 4-20-54

Oil well

TD 2823

8" @ 90

Bart 2764 Miss. 2823

TD 2823

5" @ 2822

CO to TD 40/2785-95 sd-oil-frac

250M-A f/50boph F/100 bo 8 hr.

Comp. 25 bopd

COMPLETED

County Butler State Kansas

Sec. 23 (Blk. 29) (Sur. Rge.) 5E Map No.

Operator H. H. Blair

Well No. 2 Farm Lewis

Elev. 1335 Location SE NE SW

COMPLETE					

990 Ft. From N Line SW

330 Ft. From E Line Quarter

1st. Report

Completion JUN 2 1954

Remarks Fox Bush Pool

Spudding Date 4-20-54

Drlg. Data Oil well TD 2823

8" @ 90 Bart. 2764 Miss. 2823

TD 2823 5" @ 2822 CO to TD 40/ 2785-95

sd-oil-frac 250 M-A F/ 50 boph

F/ 100 bo 8 hr. Comp. 25 bopd

COMPLETED