


Section 32 Township 18 Range 6 WWell No. # 2 HoffmanCompany Atlantic

NORTH

WEST

EAST

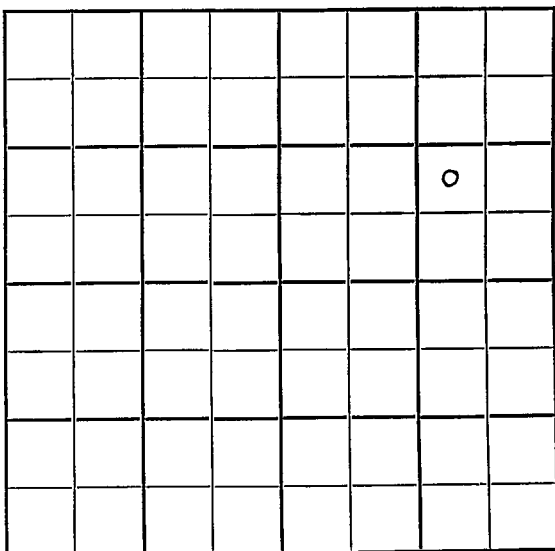

SOUTH

Rice

KANSAS

Sec. 32 Twp. 18 R. 6 W V

Well No. # 2 Hoffman Farm

Atlantic

Company

Jackson Drlg.

Contractor

Odessa Pool

Ft. from N. Line

990


Ft. from S. Line

990

Ft. from E. Line

Ft. from W. Line

NW SE NE

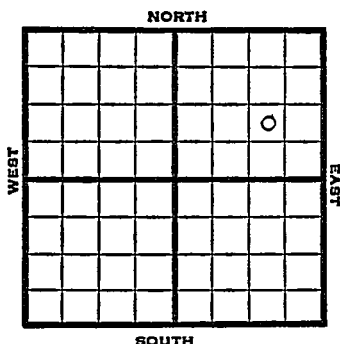

1951

Elev. 1670' REPORT

5/29

Spud 5-28-51
Drlg. 65'

7/25

Spud 5-28-51 D & A TD 3446'
9-5/8" @ 197 Lans. 2758'
DST 3071-3109 open 1 hr. rec 240' OCM
Misenor 3404' TD 3446' 7" @ 3150
42/3098-3105 5 GW SSO 21/3098-3105
B/ 18 GO 10 GWPH 250 A S/1 BO
2 BWPH CO to 3118' 18/3098-3102
1 GWPH 500 A S/5 BOPH 25% water
S/3 BFPH 70% water B/2 GO 17 GWPH
1000 A S/8 BW 1 1/2 BOPH S/13 BO
107 BW S/150 BW 8 BO 20 hr.
D & A

ABANDONED

County Rice State KansasSec. 32 (Blk.) 18 (Sur.) 6W Map No.Operator AtlanticWell No. 2 Farm HoffmanElev. Location NW SE NE

FIRST REPORT

990 Ft. From S Line NE990 Ft. From E Line Quarter1st. Report MAY 29 1951


Completion

Remarks

Jackson Drlg. - Contr.Spudding Date 5-28-51Drlg. Data Odessa Pooldrlg. 65'

J. E. TYRA

County Rice State Kansas
 Sec. 32 (Blk. 18 (Sur. 6W Map No.
 (Twp.) (Rge.)
 Operator Atlantic
 Well No. 2 Farm Hoffman
 Elev. 1670 Location NW SE NE

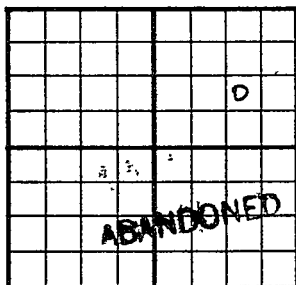

990 Ft. From S Line NE
990 Ft. From E Line Quarter
 1st. Report
 Completion JUL 25 1951
 Remarks Odessa Pool
Jackson Drlg. - Contr.
 Spudding Date 5-28-51

Drlg. Data D & A TD 3446
9 5/8" @ 197 Lans. 2758 DST 3071-3109
open 1 hr. Rec. 240' ocm Misenor 3404
TD 3446 7" @ 3150 42/ 3098-3105
5 gw SSO 21/ 3098-3105 B/ 18 go
10 gwph 250 A S/ 1 bo 2 bwph CO to
3118 18/ 3098-3102 1 gwph 500 A
S/ 5 boph 25% water S/ 3 bfph 70% water
B/ 2 go 17 gwph 1000 A S/ 8 bw 1 1/2 boph
S/ 130 bbf 107 bw S/ 150 bw 8 bo 20 hr.
D & A

J. E. TYRA