


Section 33 Township 18 Range 6 W

Well No. # 2 Habiger

Company Atlantic Refg.

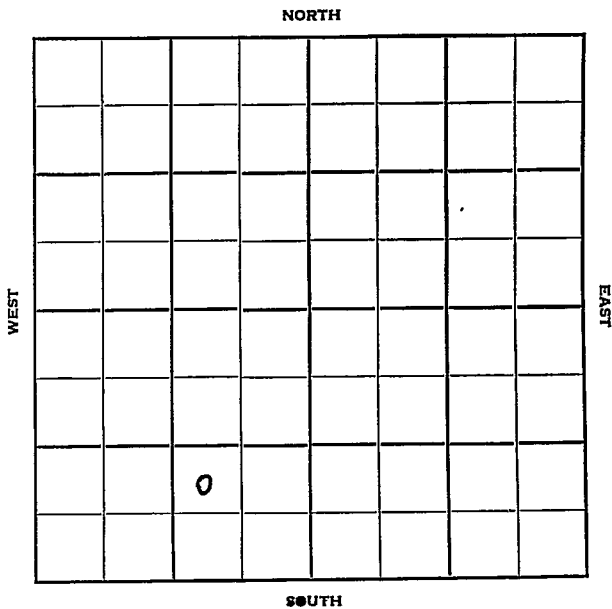

Sec. 33 Twp. 18 R. 6W

Well No. #2 Habiger Farm

Atlantic Refg. Company


Contractor

Ft. from N. Line

990 Ft. from S. Line

990 Ft. from E. Line

Ft. from W. Line

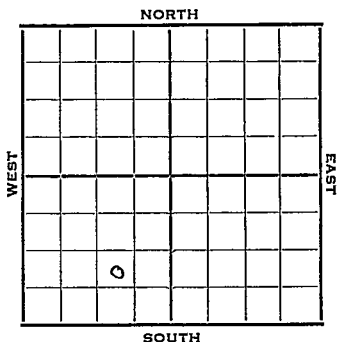

NW SE SW

1952

Elev. 1669' REPORT

6/18 Spud 6-18-52  
8" @ 210' WOG

6/25 Heeb 2595'  
Drlg. 2705'

7/2 Br Li 2740 Lans. 2771  
DST 3108-27 1 hr. 150' fluid  
Hvy OC 510# TD 3177  
4" @ 3175 WOG

7/9 DP CO 3143 64/3120-28 20 gal/fph  
500 A S/4 boph POP

7/16 Spud 6-18-52  
Oil well TD 3177' 8" @ 210  
Heeb 2595' Br. line 2740' Lans. 2771'  
DST 3108-27 open 1 hr. rec 150' fluid  
510# TD 3177' 4" @ 3175 CO to 3143  
64/3120-28 20 GFPH 500 A S/4 BOPH  
P/40 BO 9 hr.  
Comp. 75 BOPD

**COMPLETED**



