


KANSAS

Section 33 Township 18 Range 6-W

Well No. #1 Kasperek

Company Atlantic Ref.
Odessa Pool

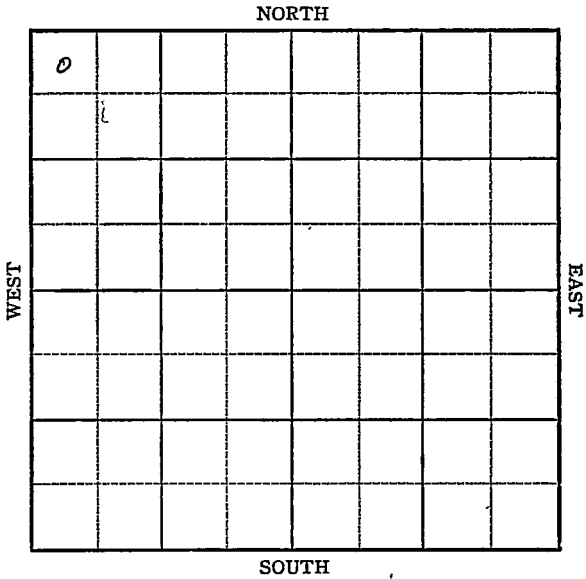

Rice **KANSAS** ✓

Sec. 33 Twp. 18 R. 6W

Well No. #1 Kasparek Farm

Atlantic Ref. Company


Odessa Pool (Herndon Drlg., ~~North~~ Contr.)

330' Ft. from N. Line

_____ Ft. from S. Line

_____ Ft. from E. Line

330' Ft. from W. Line

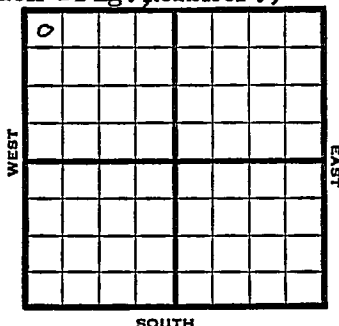

NW/C

1949	Elev. 1657' REPORT
11/30 12/7	8" @ 204' Lansing 2742' TD 3151' 5" @ 3149'
12/14	24 shots 3097-3102-900 acid Swb 14 bbls oil PH
12/28	Lans. 2742' 5" @ 3149' Perf Acid 900 Pump 76 oil Pot. Gr. 39° TD 3151' COMPLETED

Map No. _____ Sec. 33 Twp. 18 R. 6W

Well No. 1 Kasparek

_____ Atlantic Ref. _____ Company

_____ Herndon Drlg. _____ Contractor

NW/C

**FIRST REPORT
SECTION PLAT**

330 Ft. from N. Line

_____ Ft. from S. Line

_____ Ft. from E. Line

330 Ft. from W. Line

°			

Rice County

Location _____

Rig up _____

Drilling and Remarks:

8" @ 204

RECORD

Cased _____ in., _____ ft.

Sand _____

Gas _____

Oil _____

Total Depth _____

PRODUCTION

1st 24 hrs. Nat. _____

1st 24 hrs. after shot _____

Gas _____ Cu. Ft.

Dry Hole _____

Abandoned _____

Date .

NOV 30 1940 19

S. J. LEWIS

Scout

Kansas

Map No. _____ Sec. 33 Twp. 18 R. 6W

Well No. 1 Kasperek

Atlantic Ref.

Company

COMPLETE

Contractor

NW/C

E 1165?
SECTION PLAT

330 Ft. from N. Line

_____ Ft. from S. Line

_____ Ft. from E. Line

330 Ft. from W. Line

0			

Rice County

Location _____

Rig up _____

Drilling and Remarks: _____

Lowe 2742

5" C 2149

Perf.
900 acid

Pump 76 oil RT

299-80

RECORD

Cased _____ in., _____ ft.

Sand _____

Gas _____

Oil _____

Total Depth 3151

PRODUCTION

1st 24 hrs. Nat. _____

1st 24 hrs. after shot _____

Gas _____ Cu. Ft.

Dry Hole _____

Abandoned _____

Date

DEC 28 1949 19

S. I. LEWIS

Scout