


Russell

Map No. _____ Sec. 36 Twp. 15 R. 15th

Well No. 1- Gogberg Farm _____
Central Pitt Co. Company _____

330 Ft. from N. Line
____ Ft. from S. Line
____ Ft. from E. Line
330 Ft. from W. Line
Elev. 1908

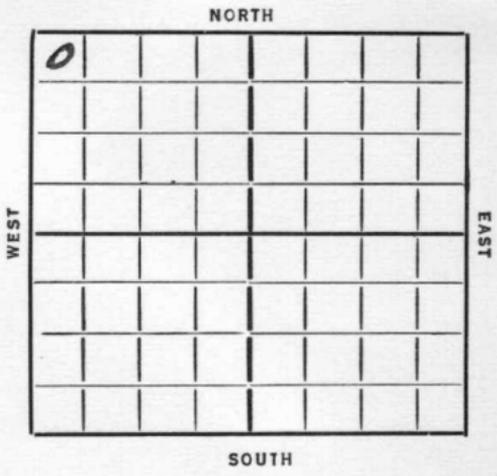

Date	REPORT
1935	
9/17	Location
10/3	Run
10/10	Apuk.
11/1	slg 1385 Aubry 930
11/7	" 2345
11/14	8" 2481 TD 2575 wk 8"
11/21	slg 2650 8" 2612
11/29	3835 = 3045 SLM
	Av 3035-45 Est 200' + shv
	gas 3090-3101 Co.
12/6	Top av. 3140 Corrected
	6" 3140 Pay 3147-51 TD
	2500' Oil ylls.
12/13	Swabbed 178 Oil 1 1/2 hrs at rate of 10 Bbls per hr after head was off
	6" 3140
12/18	slg 3155 Well acidize
	Acid 3140
	TD 3155
	2000 acid
	884 Bbls.

COMPLETED

KANSAS

Map No. 73 Sec. 36 Twp. 15 R. 15^W

Well No. 1-Bohberger

Central Pet Co Company

Contractor

FIRST REPORTS

SECTION PLAT

330 Ft. from N. Line

..... Ft. from S. Line

..... Ft. from E. Line

330 Ft. from W. Line

0			

Location

Rig up.....

Drilling and Remarks:

RECORD

Cased.....in.,ft.

Sand.....

Gas.....

Oil.....

Total Depth.....

PRODUCTION

1st 24 hrs. Nat.....

1st 24 hrs. after shot.....

Gas.....Cu. Ft.

Dry Hole.....

Abandoned.....

Date

9-12-35 192

ORVAL MANNSCHECK

Scout

Map No. 73 Sec. 36 Twp. 15 R. 15W

Well No. 1-Bohberger

Central pit. Company

Contractor

COMPLETE

SECTION PLAT

330 Ft. from N. Line

..... Ft. from S. Line

..... Ft. from E. Line

330 Ft. from W. Line

0			

Location.....

Rig up.....

Drilling and Remarks:

2000 sand

884 bbls

RECORD

Cased in, ft.

Sand 3140

Gas.....

Oil.....

Total Depth 3155

PRODUCTION

1st 24 hrs. Nat.....

1st 24 hrs. after shot.....

Gas..... Cu. Ft.

Dry Hole.....

Abandoned.....

Date

12-18-35 192.....

ORVAL MANSCHROCK

Scout