


Section 36 Township 15 Range 15-W

Well Number 1 Denies

Company S. A. Murphy et al

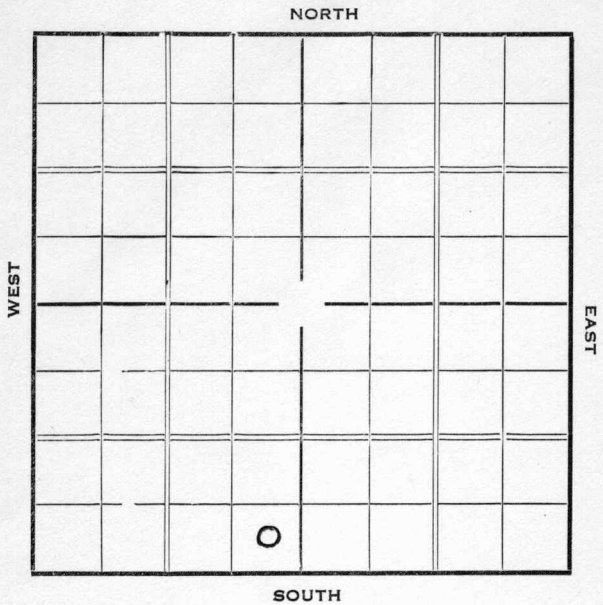

1937

6/16 Sil. 3451'.

T.D. 3479'. H.F.W.

ABANDONED

Map No. _____ Sec. 36 Twp. 15 R. 15W.Well No. 1 DennisS. A. Murphy & Co. Company
Contractor

SECTION PLAT

_____ Ft. from N. Line

330 Ft. from S. Line330 Ft. from E. Line

_____ Ft. from W. Line

FIRST REPORT

Location ✓

Rig up _____

Drilling and Remarks:

RECORD

Cased _____ in., _____ ft.

Sand _____

Gas _____

Oil _____

Total Depth _____

PRODUCTION

1st 24 hrs. Nat. _____

1st 24 hrs. after shot _____

Gas _____ Cu. Ft.

Dry Hole _____

Abandoned _____

Date

MAR 10 1937

19

S. J. LEWIS Scout

Russell KANSAS

Map No. 73 Sec. 36 Twp. 15 R. 15^wWell No. 1 - DencesS. A. Murphy et al. Company
Contractor

ABANDONED

ABANDONED

SECTION PLAT

0

 Ft. from N. Line330 Ft. from S. Line330 Ft. from E. Line Ft. from W. LineLocation Rig up

Drilling and Remarks:

H.F.W.DVA

RECORD

Cased in., ft.Sand 511 3451Gas Oil Total Depth 3479

PRODUCTION

1st 24 hrs. Nat. 1st 24 hrs. after shot Gas Cu. Ft.Dry Hole Abandoned

Date

JUN 16 1937 19

H. D. Hatfield Scout