


Map No. _____ Sec. 24 Twp. 29 R. 5
Well No. 3 Bush Farm
Gardner & Smith Company

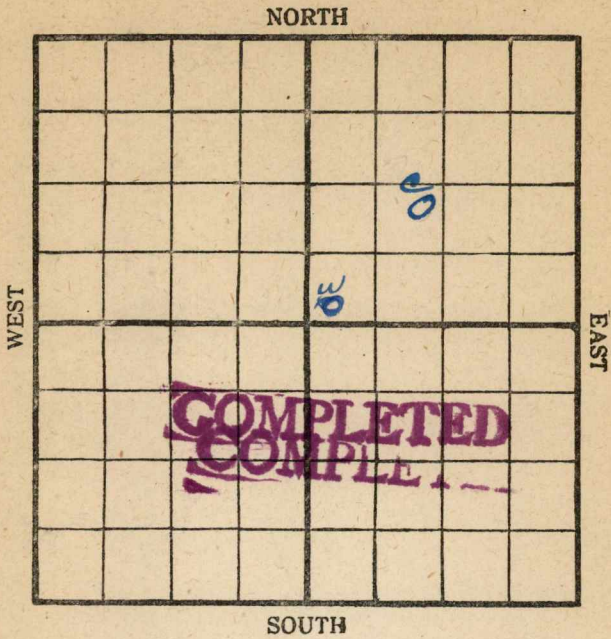

Location _____

Drilling Remarks: _____

Rig Up _____

Drilling Remarks: _____

RECORD

Cased _____ in. _____ ft.
Sand _____
Gas _____
Oil _____
Total Depth _____


PRODUCTION

1st 24 hrs. Nat. _____
1st 24 hrs. after shot _____
Gas _____ cu. ft
Dry Hole _____
Abandoned _____

Map No. K11 Sec. 24 Twp. 29 R. 5Well No. 3 Bush Farm
Gardner & Smith Company

NORTH

WEST

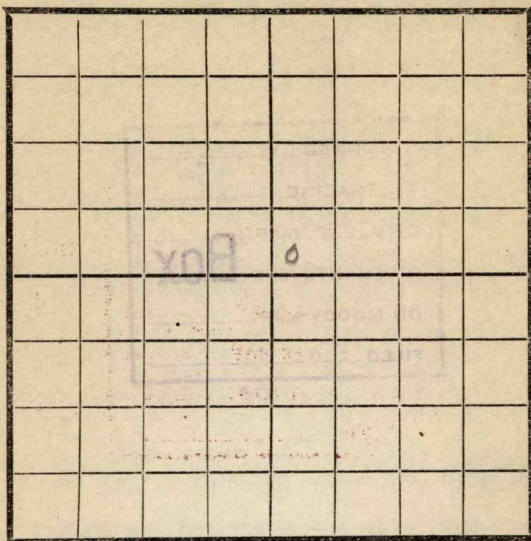

EAST

SOUTH

Location ✓Rig Up ✓

Drilling and remarks

RECORD

Cased _____ in _____ Ft.

Sand _____

Gas _____

Oil _____

Total Depth _____

PRODUCTION

1st 24 hrs. Nat. _____

1st 24 hrs. after shot _____

Gas _____ Cu. Ft.

Dry Hole _____

Abandoned _____

FIRST REPORT


Date

3/27, 1918 C. Condy Scout

Map No. _____ Sec. 24 Twp. 29 R. 5Well No. 3 Bush Farm _____
a No 1 Company _____

NORTH

WEST

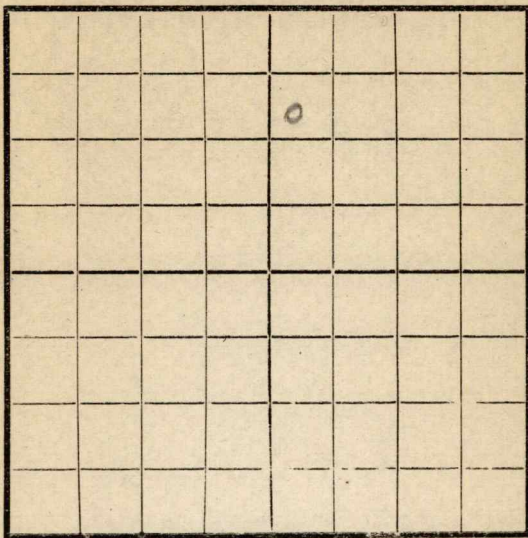

EAST

SOUTH

Location _____

Rig Up _____

Drilling and remarks

1465

RECORD

Cased _____ in. _____ Ft.

Sand _____

Gas _____

Oil _____

Total Depth _____

PRODUCTION

1st 24 hrs. Nat. _____

1st 24 hrs. after shot _____

Gas _____ Cu. Ft.

Dry Hole _____

Abandoned _____

Date

APR 3 1918

_____, 191


Candy

Scout

Map No. _____ Sec. 24 Twp. 29 R. 5Well No. 3 Bush _____ Farm_____ Co. No 1 _____ Company

NORTH

WEST

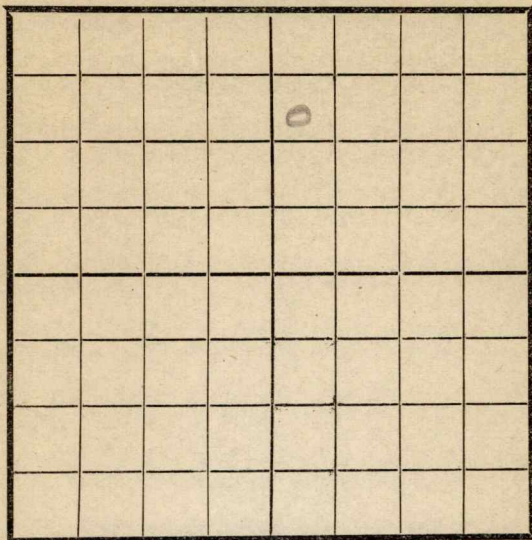

EAST

SOUTH

Location _____

Rig Up _____

Drilling and remarks

RECORD

Cased _____ in. _____ Ft.

Sand _____

Gas _____

Oil _____

Total Depth _____

PRODUCTION

1st 24 hrs. Nat. _____

1st 24 hrs. after shot _____

Gas _____ Cu. Ft.

Dry Hole _____

Abandoned _____


Date

4/10, 1918 S. C. Cady Scout

Map No. _____ Sec. 24 Twp. 29 R. 5
 Well No. 3 Bush Farm _____
Andrew Company _____

NORTH

WEST

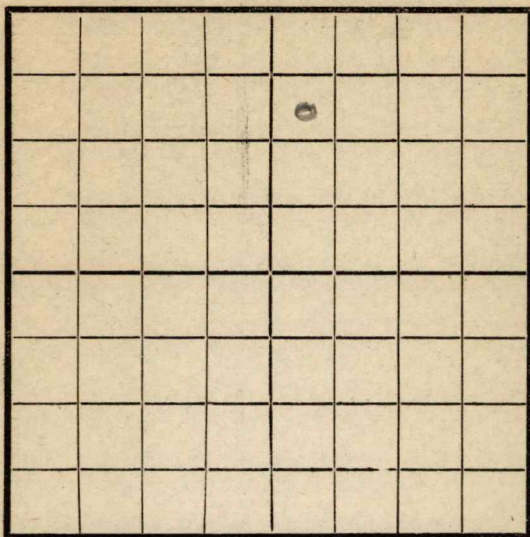

EAST

SOUTH

Location _____
 Rig Up _____
 Drilling and remarks

RECORD

Cased _____ in. _____ Ft.
 Sand _____
 Gas _____
 Oil _____
 Total Depth _____

PRODUCTION


1st 24 hrs. Nat. _____
 1st 24 hrs. after shot _____
 Gas _____ Cu. Ft.
 Dry Hole _____
 Abandoned _____

Date

3/27, 1918 E. C. May Scout

Map No. K11 Sec. 24 Twp 29 R. 5Well No. 3 Bural FarmGardner & Smith Company

NORTH

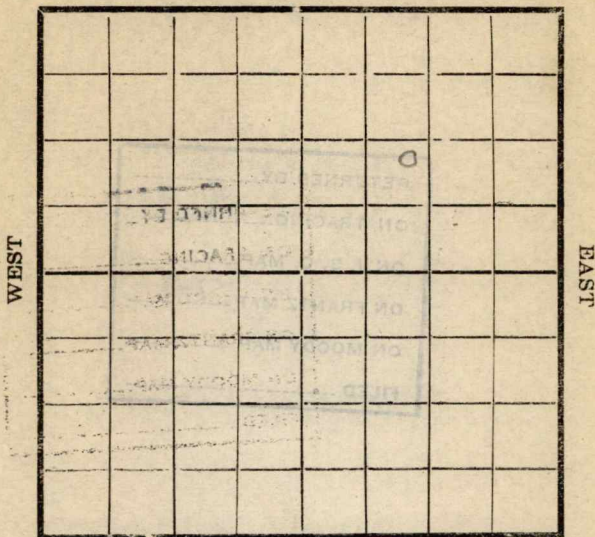

SOUTH

Location -----

Rig Up ☒ -----

Drilling and remarks

RECORD

Cased ----- in. ----- Ft.

Sand -----

Gas -----

Oil -----

Total Depth -----

PRODUCTION

1st 24 hrs. Nat. -----

1st 24 hrs. after shot -----

Gas ----- Cu. Ft.

Dry Hole -----

Abandoned -----

FIRST REPORT

Date

5/20, 1918 Candey Scout

Map No. _____ Sec. 24 Twp. 29 R. 5Well No. 3 BushSanborn & Smith Company

Contractor _____

NORTH

WEST

EAST

SOUTH

Location _____

Rig up _____

Drilling and Remarks:

300

RECORD

Cased _____ in., _____ ft.

Sand _____

Gas _____

Oil _____

Total Depth _____

PRODUCTION

1st 24 hrs. Nat. _____

1st 24 hrs. after shot _____

Gas _____ Cu. Ft.

Dry Hole _____

Abandoned _____

Date

6/26 1918 C. C. Cuddy Scout

Map No. _____ Sec. 24 Twp. 29 R. 5Well No. 3 BunkerSanborn & Smith Company

Contractor _____

NORTH

WEST

EAST

SOUTH

Location _____

Rig up _____

Drilling and Remarks:

950

RECORD

Cased _____ in., _____ ft.

Sand _____

Gas _____

Oil _____

Total Depth _____

PRODUCTION

1st 24 hrs. Nat. _____

1st 24 hrs. after shot _____

Gas _____ Cu. Ft.

Dry Hole _____

Abandoned _____

Date

7/3


191

J. Canby Scout

Map No. _____ Sec. 24 Twp. 29 R. 5
 Well No. 3 Bush
Garland Smith Company
 _____ Contractor

NORTH

WEST

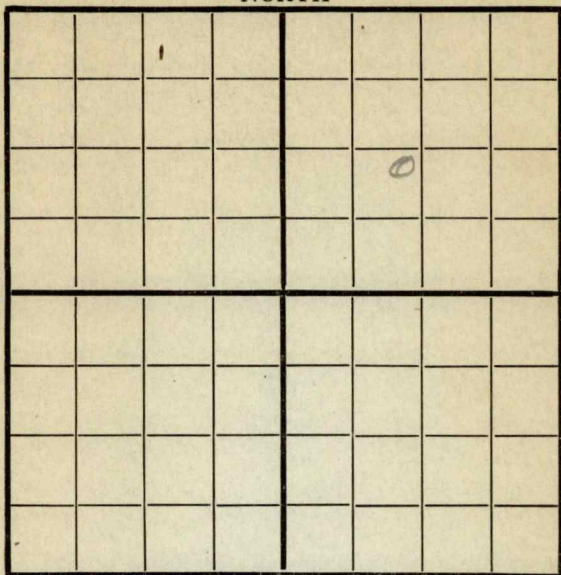

EAST

SOUTH

Location _____

Rig up _____

Drilling and Remarks:

1510

RECORD

Cased _____ in., _____ ft.

Sand _____

Gas _____

Oil _____

Total Depth _____

PRODUCTION

1st 24 hrs. Nat. _____

1st 24 hrs. after shot _____

Gas _____ Cu. Ft.

Dry Hole _____


Abandoned _____

Date

7/10191f. C. Cady

Scout

Map No. _____ Sec. 24 Twp. 29 R. 5
Well No. 3 Bush
Garden 9 south Company _____
Contractor _____

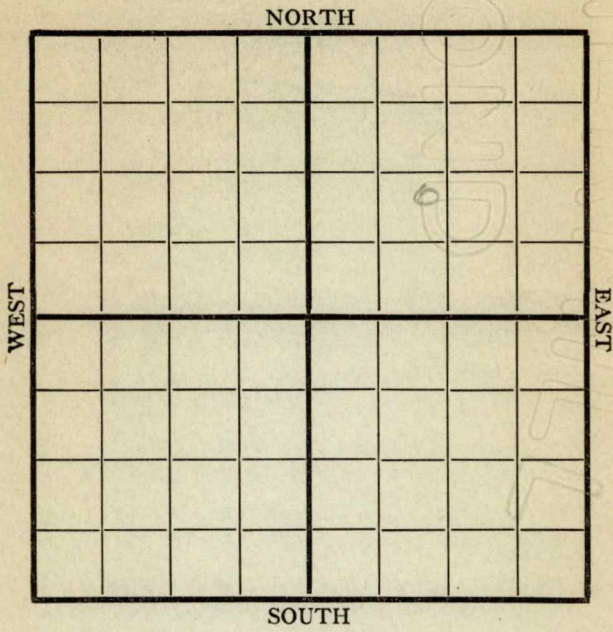

Location _____ Rig up _____ Drilling and Remarks: <u>Fishing</u> <u>1580</u>	RECORD Cased _____ in., _____ ft. Sand _____ Gas _____ Oil _____ Total Depth _____ PRODUCTION 1st 24 hrs. Nat. _____ 1st 24 hrs. after shot _____ Gas _____ Cu. Ft. Dry Hole _____ Abandoned _____
---	--

Map No. _____ Sec. 24 Twp. 29 R. 5Well No. 3 Bush

_____ Company

_____ Contractor

NORTH

WEST

EAST

SOUTH

Location _____

Rig up _____

Drilling and Remarks:

1780

RECORD

Cased _____ in., _____ ft.

Sand _____

Gas _____

Oil _____

Total Depth _____

PRODUCTION

1st 24 hrs. Nat. _____

1st 24 hrs. after shot _____

Gas _____ Cu. Ft.

Dry Hole _____

Abandoned _____

Date

7/24 1911 F. Conroy Scout


Map No. _____ Sec. 24 Twp. 29 R. 5Well No. 3 BrushGardner & Smith Company

Contractor _____

NORTH

WEST

EAST

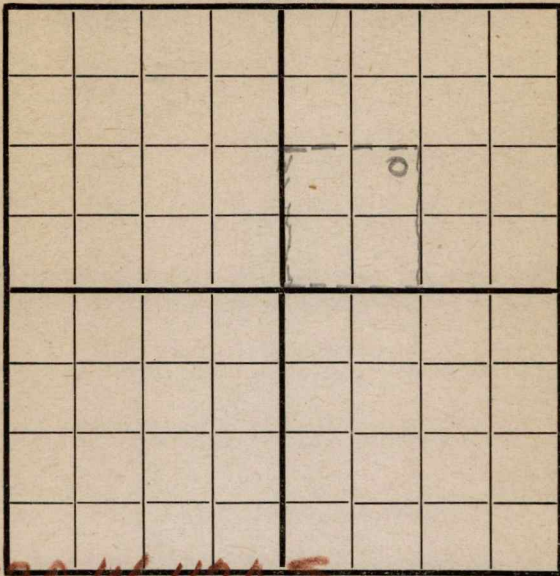

SOUTH

Location _____

Rig up _____

Drilling and Remarks:

1950

RECORD

Cased _____ in., _____ ft.

Sand _____

Gas _____

Oil _____

Total Depth _____

PRODUCTION

1st 24 hrs. Nat. _____

1st 24 hrs. after shot _____

Gas _____ Cu. Ft.

Dry Hole _____

Abandoned _____

Date

7/31

191

S. C. Carey

Scout

Map No. _____ Sec. 24 Twp. 29 R. 5

Well No. 3 Bush
Gordon & Smith Compa

Contract

NORTH

WEST

EAST

SOUTH

Location _____

Rig up

Drilling and Remarks:

2100.

RECORD

Cased-----in., -----ft.

Sand_____

Gas -----

Oil_____

Total Depth_____

PRODUCTION

1st 24 hrs. Nat. -----

1st 24 hrs. after shot-----

Gas.....Cu. Ft.

Dry Hole.....

Abandoned.....

Date _____

872

191

P. Condy


Scout

Map No. _____ Sec. 24 Twp. 29 R. 5Well No. 3 BrushGardner & Smith Company

Contractor _____

NORTH

WEST

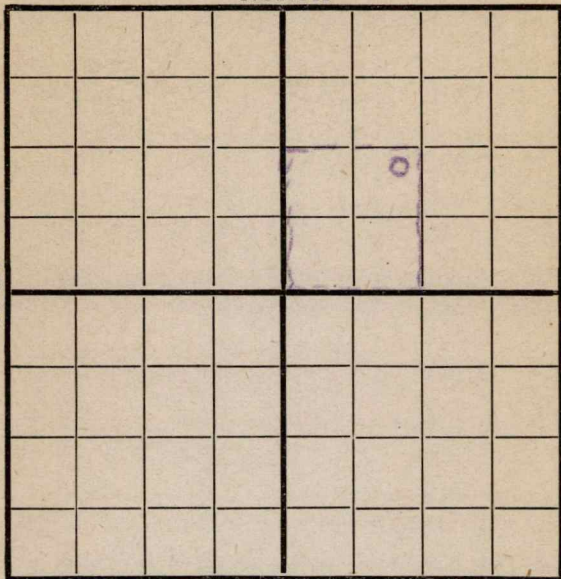

EAST

SOUTH

1120 W & S

Location _____

Rig up _____

Drilling and Remarks:

2420

RECORD

Cased _____ in., _____ ft.

Sand _____

Gas _____

Oil _____

Total Depth _____

PRODUCTION

1st 24 hrs. Nat. _____

1st 24 hrs. after shot _____

Gas _____ Cu. Ft.

Dry Hole _____

Abandoned _____

Date

8/14 1918 P. Canby Scout

WEST

EAST

SOUTH

Location _____

Rig up.....

Drilling and Remarks:

T. S.

2785

RECORD

Cased _____ in., _____ ft.

Sand_____

Gas _____

Oil _____

Total Depth_____

PRODUCTION

1st 24 hrs. Nat. -----

1st 24 hrs. after shot -----

Gas_____Cu. Ft.

Dry Hole.

Abandoned_____

Date _____

8/2, 8

Carley Scout

Map No. K11 Sec. 24 Twp. 29 R. 5

Well No. 3 Bush

Garden & Smith Company

Garden & Garden Contractor

Auguste NORTH Ko

WEST

EAST

COMPLETED

SOUTH

1120 W 2 X 1120 E Line

Location _____

Rig up _____

Drilling and Remarks:

Est at 75
Bbls

RECORD

Cased _____ in., _____ ft.

Sand 2785-2824

Gas _____

Oil _____

Total Depth _____

PRODUCTION

1st 24 hrs. Nat. _____

1st 24 hrs. after shot _____

Gas _____ Cu. Ft.

Dry Hole _____

Abandoned _____

Date

8/26 1918 Candy Scout