

KANSAS


FORM 51 5M BRIX

Ellis County

Section 3 Township 15 Range 16W

Well No. #1 H. N. Huser

Company W. L. Hartman

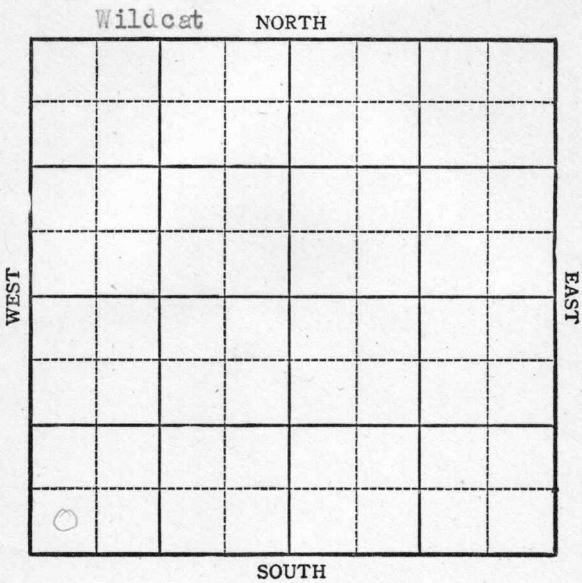

KANSAS

Ellis County

Sec. 3 Twp. 15 R. 16W

Well No. #1 H. N. Huser Farm

W. L. Hartman Company

Wildcat


 Ft. from N. Line

330 Ft. from S. Line

 Ft. from E. Line

330 Ft. from W. Line

SW/c 6 lev. 1916

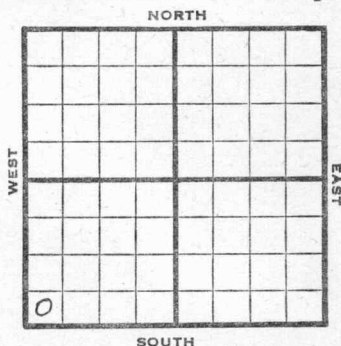

1944

R E P O R T

10/25

RUR

11/2

10" @ 247,

8" @ 1104

Anhy. 1033

Drlg. 1250

11/8

Drlg. 2230

11/16

Drlg. 3033'

11/22

Topka 2916

Lans 3189

BKC 3402

Cong 3449

Arb. 3512

TD 3530

ABANDONED

KANSAS


Pool Name WildcatMap No. 24 Sec. 3 Twp. 15 R. 16WWell No. 1 H. N. HuserW. L. Hartman Company

FIRST REPORT

Contractor

SW/C

SECTION PLAT

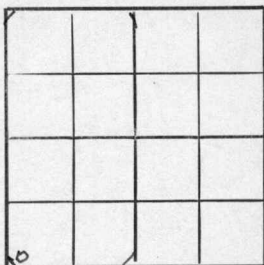 Ft. from N. Line330 Ft. from S. Line Ft. from E. Line330 Ft. from W. LineEllis CountyLocation Rig up

Drilling and Remarks:

R U R

RECORD

Cased in., ft.Sand Gas Oil Total Depth

PRODUCTION

1st 24 hrs. Nat. 1st 24 hrs. after shot Gas Cu. Ft.Dry Hole Abandoned

Date

OCT 25 1944

19

S. J. LEWIS

Scout

Pool Name WildcatMap No. 74 Sec. 3 Twp. 15 R. 16WWell No. 1 H. N. HuserW. L. Hartman


Company

ABANDONED

Contractor

SW/c

SECTION PLAT

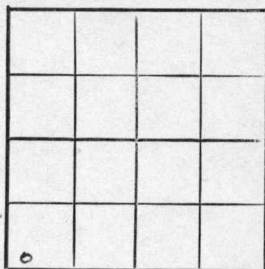 Ft. from N. Line330 Ft. from S. Line Ft. from E. Line330 Ft. from W. LineEllisLocation Rig up

Drilling and Remarks:

Topoka 2916Liana 3189BISC 3402Craig 3449Cr 3512

RECORD

Cased in., ft.Sand Gas Oil Total Depth 3530

PRODUCTION

1st 24 hrs. Nat. 1st 24 hrs. after shot Gas Cu. Ft.Dry Hole Abandoned

Date

NOV 22 194419S. J. LEWIS

Scout