Ellis KANSAS

SECTION 29 TOWNSHIP 15 RANGE 16W

WELL NO. #1 Bertha D. Scurlock

COMPANY Stanolind

NORTH NE NE NE

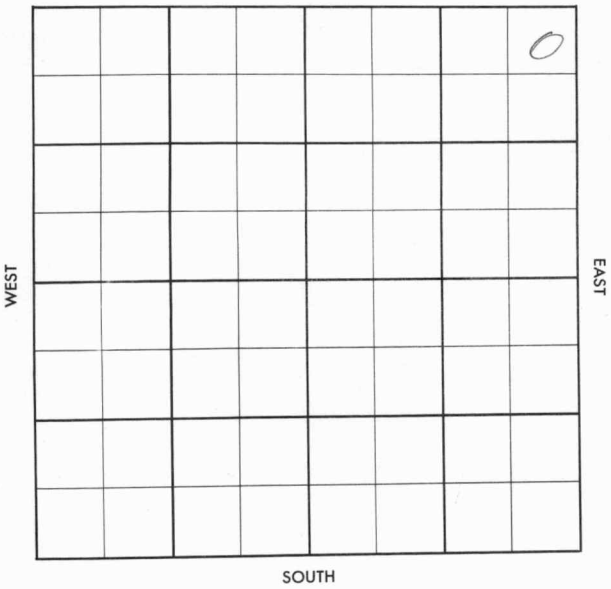

FORM 504-3 SUNRAY

FORM 513 SUNRAY

County Ellis Elev.

Sec. 29 Twp. 15 Rge. 16W

Company Stanolind

Farm Name Bertha D. Scurlock No. 1

TOPS	DEPTH	LOG	DATUM
Anh.			
Tp.			
H.			
Tr.			
Dg.			
B.L.			
L.			
K.C.			
B.K.C.			
Ce.			
C.			
M.			
M.			
K.			
Mz.			
Mq.			
V.			
S.			
S.			
A			
R.			
P€.			
G.			
T.D.			

Loc. in Sec. NE NE NE

Geol.

Contr. Transit

Pool Scurlock

JAN 30 57

FIRST REPORT

Date Comm. 1-27-57

drlg. 366

Co. Lse. No. Sec. T. R.

FORM 513 SUNRAY

County Ellis Elev. 1856

Sec. 29 Twp. 15 Rge. 16W

Company Stanolind

Farm Name Bertha D. Scurlock No. 1

TOPS	DEPTH	LOG	DATUM
Anh.	985		
Tp.			
H.	3100		
Tr.			
Dg.			
B.L.			
L.	3151		
K.C.			
B.K.C.			
Ce.			
C. sd	3428		
M.			
M.			
K.			
Mz.			
Mo.			
V.			
S.			
S.			
A	3448		
R.			
Pe.			
G.			
T.D.	3500		

Loc. in Sec. NE NE NE

Geol.

Contr. Transit

Pool Scurlock

FEB 20 '57

ABANDONED

Date Comm. 1-27-57

drlg. 366 FEB 6 '57 878 991/600

Ø 2715 FEB 13 '57 DST 2172-82

30" rec 2½' Ø Md BHP 895

/30" DST 3215-29 2 hrs

rec 93' MSW BHP 1062/1hr

DST 3423-39 op 80" rec 4'

VSO spkd Md BHP 100/30"

DST 3445-56 op 1hr rec 31'

MSW BHP 737/30" Ø 3500

O & A

Co. Lse. No. Sec. T. R.