

Map No. _____ Sec. 24, Twp. 29, R. 2

Well No. L Bush Farm 1

Q # 1 Oil Company

NORTH

WEST

EAST

COMPLETED

SOUTH

Location _____

Drilling Remarks:

Rig up -----

Drilling Remarks:

RECORD

Cased _____ in. _____ ft.

Sand

Gas

Oil

Total Depth.....

PRODUCTION

1st 24 hrs. Nat. -----

1st 24 hrs. after shot -----

Gas Cu. Ft.

Dry Hole


Abandoned

Map No. K11 Sec. 24 Twp. 29 R. 5Well No. 2 Bush Farm
A No 1 Company

NORTH

WEST

EAST

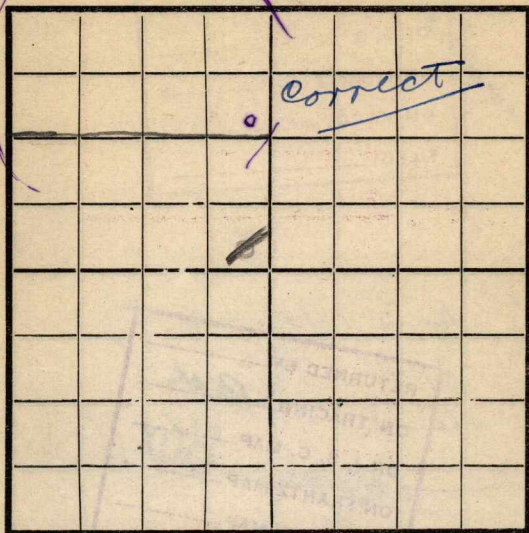

SOUTH

Location -----

Rig Up -----

Drilling and remarks -----

RECORD

Cased ----- in ----- Ft.

Sand -----

Gas -----

Oil -----

Total Depth -----

PRODUCTION

1st 24 hrs. Nat. -----

1st 24 hrs. after shot -----

Gas ----- Cu. Ft.

Dry Hole -----

Abandoned -----

FIRST REPORT


Date

12/5, 1917, Candiff Scout

Map No. _____ Sec. 24 Twp. 29 R. 5Well No. 2 Bush Farm _____
A H Oil Co Company

NORTH

WEST

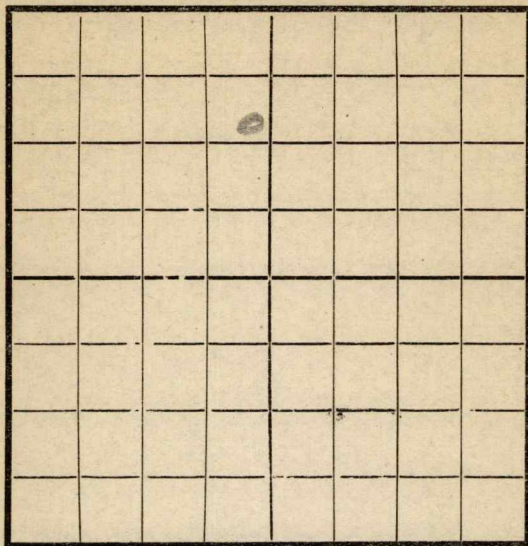

EAST

SOUTH

Location _____

Rig Up _____

Drilling and remarks _____

RECORD

Cased _____ in. _____ Ft.

Sand _____

Gas _____

Oil _____

Total Depth _____

PRODUCTION

1st 24 hrs. Nat. _____

1st 24 hrs. after shot _____

Gas _____ Cu. Ft.

Dry Hole _____

Abandoned _____


Date

1/2, 1918 J. Conley Scout

Map No. _____ Sec. 24 Twp. 29 R. 5
 Well No. 2 Bush Farm _____
a No 1 Oil Company _____

NORTH

WEST

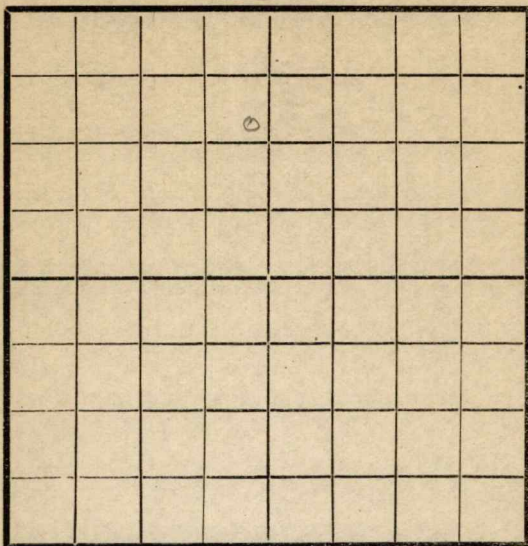

EAST

SOUTH

Location _____
 Rig Up _____
 Drilling and remarks _____

Spudding

RECORD

Cased _____ in. _____ Ft.
 Sand _____
 Gas _____
 Oil _____
 Total Depth _____

PRODUCTION

1st 24 hrs. Nat. _____
 1st 24 hrs. after shot _____
 Gas _____ Cu. Ft.
 Dry Hole _____
 Abandoned _____


Date

1/9, 1918 *S. Condy* Scout _____

Map No. _____ Sec. 24 Twp. 29 R. 5
 Well No. 2 Bush Farm _____
A No 1 Oil Company _____

NORTH

WEST

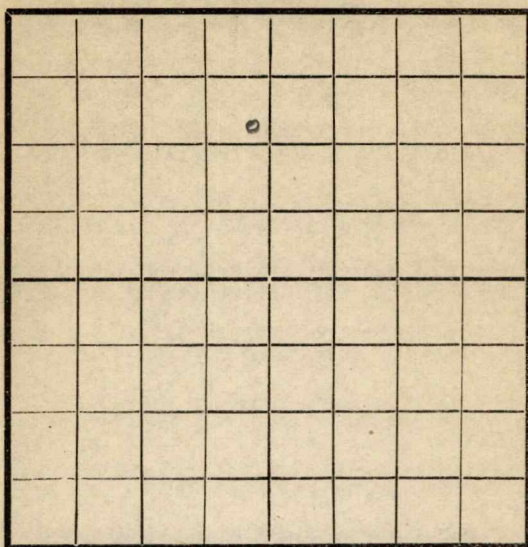

EAST

SOUTH

Location _____

Rig Up _____

Drilling and remarks

*Spudded
in
and
S.D.*

RECORD

Cased _____ in _____ Ft.

Sand _____

Gas _____

Oil _____

Total Depth _____

PRODUCTION

1st 24 hrs. Nat. _____

1st 24 hrs. after shot _____

Gas _____ Cu. Ft.

Dry Hole _____

Abandoned _____


Date

1/16, 1918 Candy Scout

Map No. _____ Sec. 24 Twp. 29 R. 5Well No. 2 Bush Farm _____
C. No. 1 Company _____

NORTH

WEST

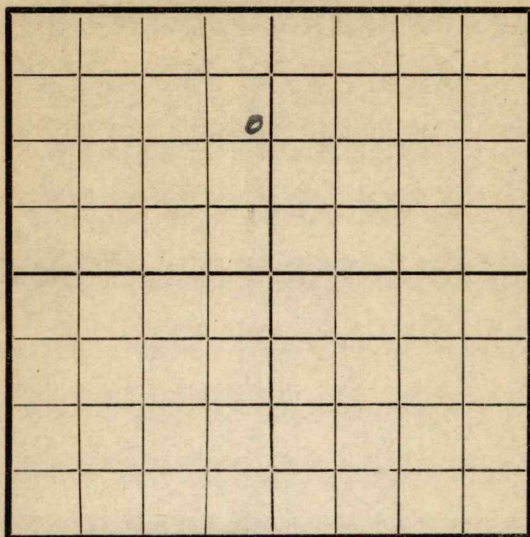

EAST

SOUTH

Location _____

Rig Up _____

Drilling and remarks

435'

RECORD

Cased _____ in. _____ Ft.

Sand _____

Gas _____

Oil _____

Total Depth _____

PRODUCTION

1st 24 hrs. Nat. _____

1st 24 hrs. after shot _____

Gas _____ Cu. Ft.

Dry Hole _____

Abandoned _____


Date

1/23, 1918 8 Condit Scout

Map No. _____ Sec. 24 Twp 29 R. 5Well No. 2 Bush Farm _____
A No 1 Company _____

NORTH

WEST

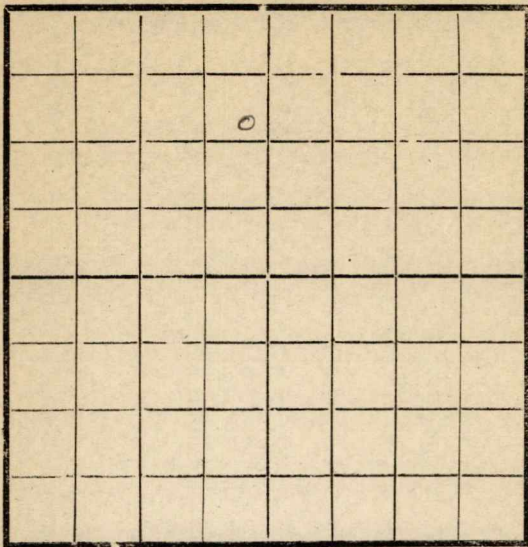

EAST

SOUTH

Location _____

Rig Up _____

Drilling and remarks

610

RECORD

Cased _____ in. _____ Ft.

Sand _____

Gas _____

Oil _____

Total Depth _____

PRODUCTION

1st 24 hrs. Nat. _____

1st 24 hrs. after shot _____

Gas _____ Cu. Ft.

Dry Hole _____

Abandoned _____

Date

1/30


191

E. Condit

Scout

Map No. _____ Sec. 24 Twp. 29 R. 5
 Well No. 213 Farm _____
asol Company _____

NORTH

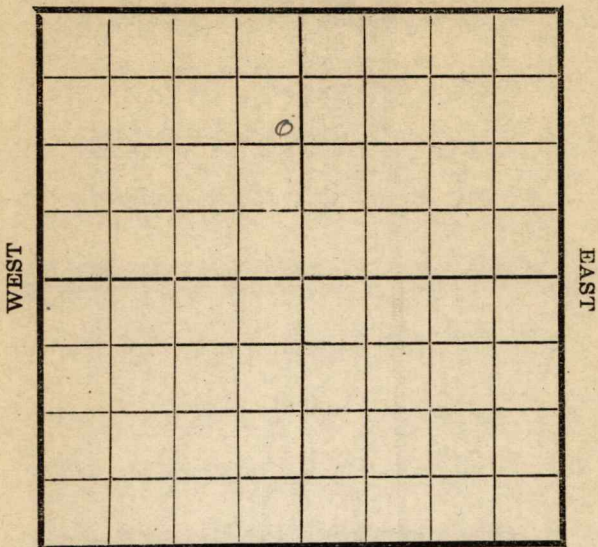

SOUTH

Location _____
 Rig Up _____
 Drilling and remarks

1000

RECORD

Cased _____ in. _____ Ft.
 Sand _____
 Gas _____
 Oil _____
 Total Depth _____

PRODUCTION

1st 24 hrs. Nat. _____
 1st 24 hrs. after shot _____
 Gas _____ Cu. Ft.
 Dry Hole _____
 Abandoned _____


Date

7/6, 1918 Scout

Map No. _____ Sec. 24 Twp. 29 R. 5Well No. 2 Bush Farm _____
Q No 1 Company _____

NORTH

WEST

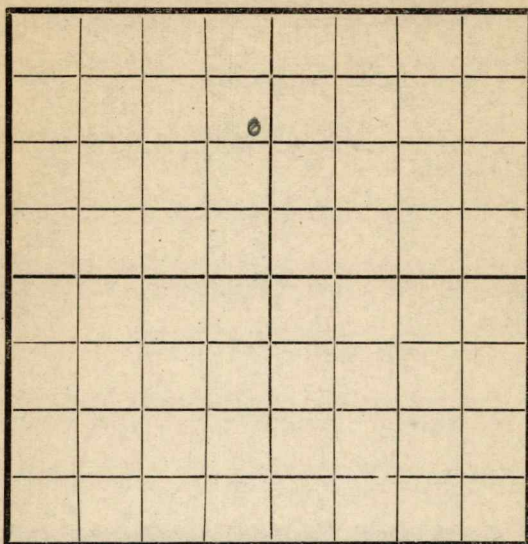

EAST

SOUTH

Location _____

Rig Up _____

Drilling and remarks

1500'

RECORD

Cased _____ in. _____ Ft.

Sand _____

Gas _____

Oil _____

Total Depth _____

PRODUCTION

1st 24 hrs. Nat. _____

1st 24 hrs. after shot _____

Gas _____ Cu. Ft.

Dry Hole _____

Abandoned _____


Date

2/13, 1918 S. Condy Scout

Map No. _____ Sec. 24 Twp. 29 R. 5
Well No. 2 Bine Farm _____
also Company _____

NORTH

WEST

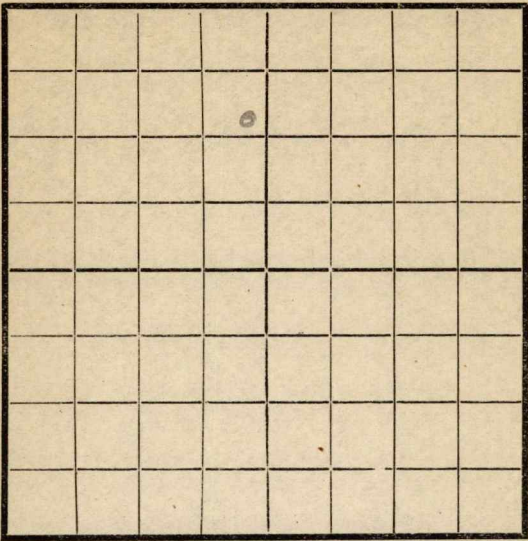

EAST

SOUTH

RECORD

Location _____
Rig Up _____
Drilling and remarks

Cased _____ in. _____ Ft.
Sand _____
Gas _____
Oil _____
Total Depth _____

PRODUCTION


1st 24 hrs. Nat. _____
1st 24 hrs. after shot _____
Gas _____ Cu. Ft.
Dry Hole _____
Abandoned _____

Date _____
2/20, 1918 C. C. Cuddy Scout

Map No. _____ Sec. 24 Twp. 29 R. 5
 Well No. 2 Bush Farm _____
A No 1 Company _____

NORTH

WEST

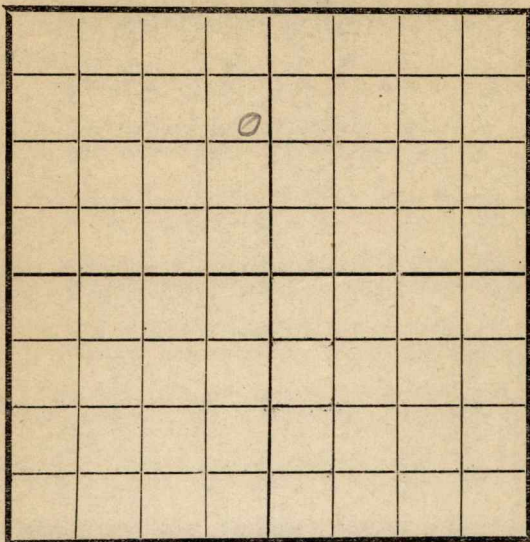

EAST

SOUTH

Location _____
 Rig Up _____
 Drilling and remarks _____

2310

RECORD

Cased _____ in. _____ Ft.
 Sand _____
 Gas _____
 Oil _____
 Total Depth _____

PRODUCTION

1st 24 hrs. Nat. _____
 1st 24 hrs. after shot _____
 Gas _____ Cu. Ft.
 Dry Hole _____
 Abandoned _____


Date

2/27, 1918 C. C. Cady Scout

Map No. _____ Sec. 24 Twp. 29 R. 5Well No. 2 Bush Farm _____
As 1 Company _____

NORTH

WEST

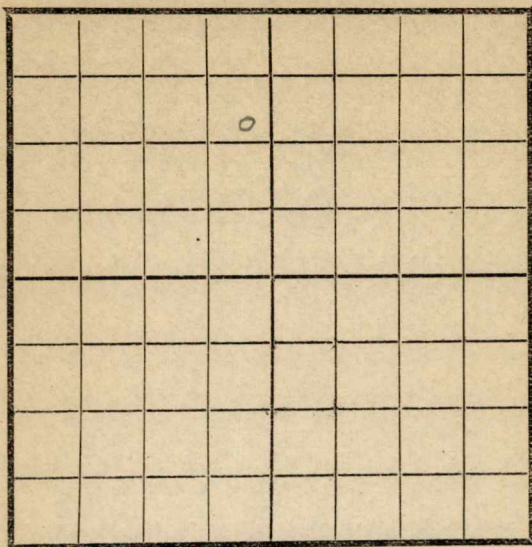

EAST

SOUTH

Location _____

Rig Up _____

Drilling and remarks

2478

RECORD

Cased _____ in. _____ Ft.

Sand _____

Gas _____

Oil _____

Total Depth _____

PRODUCTION

1st 24 hrs. Nat. _____

1st 24 hrs. after shot _____

Gas _____ Cu. Ft.

Dry Hole _____

Abandoned _____


Date

3/6, 1918 J. Condy Scout

Map No. _____ Sec. 24 Twp. 29 R. 5Well No. 2 Bush Farm _____A No 1 Company _____

NORTH

WEST

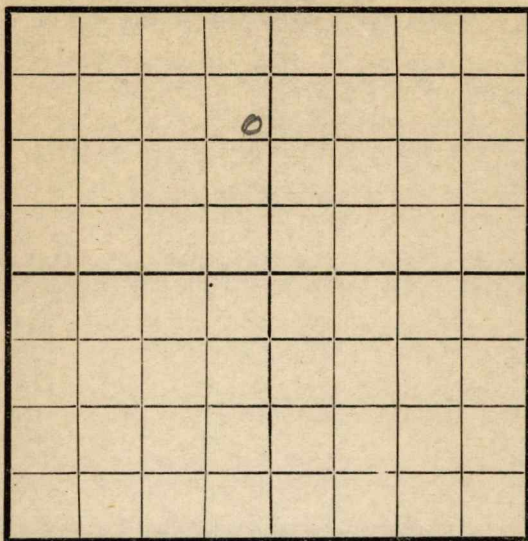

EAST

SOUTH

Location _____

Rig Up _____

Drilling and remarks

RECORD

Cased _____ in. _____ Ft.

Sand _____

Gas _____

Oil _____

Total Depth _____

PRODUCTION

1st 24 hrs. Nat. _____

1st 24 hrs. after shot _____

Gas _____ Cu. Ft.

Dry Hole _____

Abandoned _____


Date

3/13, 1918 Candiff Scout

Map No. K11 Sec. 24 Twp. 29 R. 5Well No. 2 Bush FarmA No 1 Company

NORTH

WEST

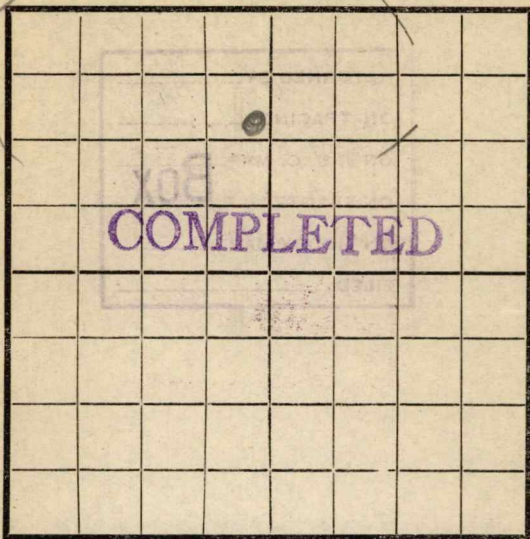

EAST

SOUTH

Location -----

Rig Up -----

Drilling and remarks

Estimated
at 150 to
200 Bbls -
Have a good
deal gas -

RECORD

Cased ----- in. ----- Ft.

Sand 2796-2832

Gas -----

Oil -----

Total Depth -----

PRODUCTION

1st 24 hrs. Nat. -----

1st 24 hrs. after shot -----

Gas ----- Cu. Ft.

Dry Hole -----

Abandoned -----

Date

3/21, 1918 Condy Scout