

Section O.W.W.O. Township 18 Range 7W


Well No. #1 Click

Company Isern & Gill & Allison

NORTH

WEST

EAST

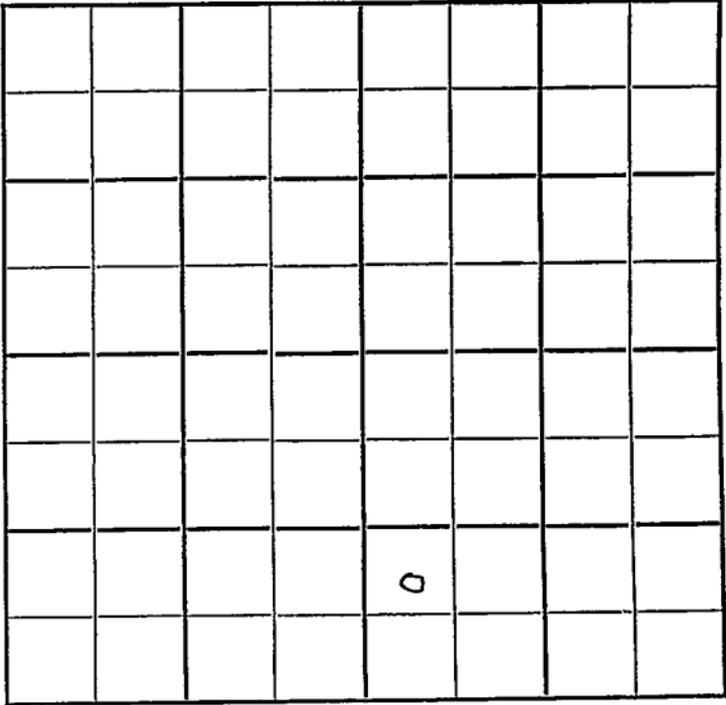

SOUTH

O.W.W.O.

Sec. 3 Twp. 18 R. 7 W

Well No. # 1 Click Farm

Isern & Gill & Allison Company

Contractor

Wildcat


Ft. from N. Line

990 Ft. from S. Line

Ft. from E. Line

330 Ft. from W. Line

NW SW SE

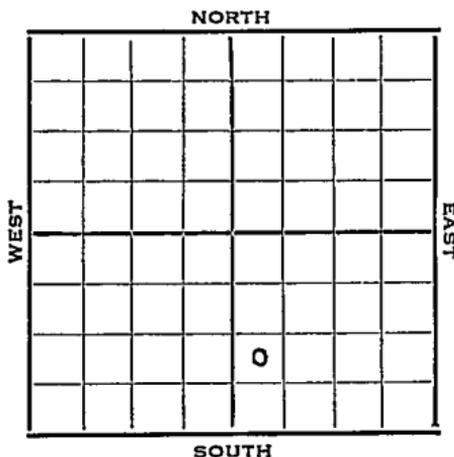

1951 Elev. 1701' REPORT

12/5 Location

1952
1/30 Spud 12-7-51
D&A TD 3166 ' 8-5/8" @ 200
KC 2733 Misener 3158
DST 3146-63 open 1/2 hr. rec. 840'
gas 180' hocm 5" @ 3161 TD 3166
500 A wtr. & SSO
D&A

ABANDONED

O.W.W.O.

1952
4/2 Lans. 2733' Mq 3158'
TD 3163' 5" @ 3161' D & A
PB 3100' 24/3067-72 NS 1000 A
S/2 1/2 BOPH decreased to 6 BOPD plus
6 BW To Re-A.

4/8 NR
4/23 Oil Well TD 3163'
Lans. 2733 Mag. 3158 OTD 3163
5" @ 3161 PB 3100
24/ 3068-72 1000 A S/ 2 1/2 boph
Dec. to 6 bopd 3500 A
Comp. 6 bopd.

COMPLETED


County Rice State Kansas

Sec. 3 (Blk. Twp.) 18 (Sur. Rge.) 7W Map No.

Operator Isern Bros.

Well No. 1 Farm Click

Elev. 1701 Location NW SW SE

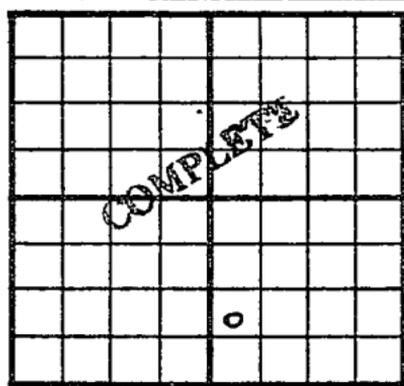

990 Ft. From S Line SE

330 Ft. From W Line Quarter

Ist. Report

Completion APR 23 1957

Remarks OWWO

Spudding Date

Drlg. Data Oil well TD 3163

Lens. 2733 Maq. 3158 OTD 3163

5" @ 3161 PB 3100 24/ 3068-72

1000 A S/ 2 1/2 boph dec. to 6 bopd

3500 A Comp. 6 bopd