

Map No. _____ Sec. 24 Twp. 54 R. 5
Well No. _____ 2 Buah Farm
_____ L. H. Oil Company

N

24

E

S

Location -----

Drilling Remarks:

Rig Up -----

Drilling Remarks:

RECORD

Cased ----- in.-----ft.

Sand -----

Gas -----

Oil -----

Total Depth-----

PRODUCTION

1st 24 hrs. Nat.-----


1st 24 hrs. after shot-----

Gas _____ cu. ft.

Dry Hole -----

Abandoned -----

660 Ft. from W. Line

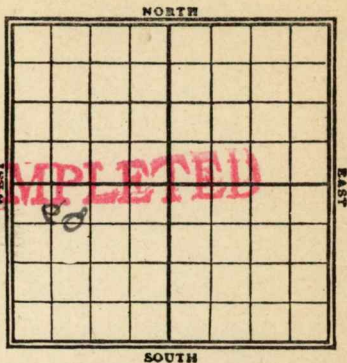

REPORT

FIRST REPORT

7.10 T.O. H.

24 e e v

3/3	- - -
-----	-------

23	Ray
4/12	

4/2

19, Tools

5/4	12 ¹ / ₂ ~ 990
-----	--------------------------------------

6/8	tap 2806'
-----	-----------

14	2790-21-27	40/60
----	------------	-------

Map No. K11 Sec. 34 Twp. 29 R. 5Well No. 3 BushD. W. Oil Company

Contractor

SECTION PLAT

460 Ft. from N. Line

Ft. from S. Line

Ft. from E. Line

660 Ft. from W. Line

FIRST REPORT

Location

Rig up

Drilling and Remarks:

T. O. G.

RECORD

Cased _____ in., _____ ft.

Sand _____

Gas _____

Oil _____

Total Depth _____

PRODUCTION

1st 24 hrs. Nat. _____

1st 24 hrs. after shot _____

Gas _____ Cu. Ft.

Dry Hole _____

Abandoned _____

Date

2/10 19120

Pyle

Scout

Map No. K11 Sec. 24 Twp. 29 R. 5Well No. 3 BushS. & S. Oil Company

Contractor

SECTION PLAT

660 Ft. from N. Line

Ft. from S. Line

Ft. from E. Line

1020 Ft. from W. Line

o			

Location

Rig up ☒

Drilling and Remarks:

*Change
Location*

RECORD

Cased _____ in., _____ ft.

Sand _____

Gas _____

Oil _____

Total Depth _____

PRODUCTION

1st 24 hrs. Nat. _____

1st 24 hrs. after shot _____

Gas _____ Cu. Ft.

Dry Hole _____

Abandoned _____

Date

3/23 1910

Scout

Pyle

Map No. K 11 Sec. 24 Twp. 29 R. 5Well No. 3 Bush0 4 0 0 4 2 Company _____

Contractor _____

SECTION PLAT

660 Ft. from N. Line

_____ Ft. from S. Line

_____ Ft. from E. Line

1020 Ft. from W. Line

Location _____

Rig up _____

Drilling and Remarks:

Shot 40 ft

RECORD

Cased _____ in., _____ ft.

Sand 2790 - 2827

Gas _____

Oil _____

Total Depth _____

PRODUCTION

1st 24 hrs. Nat. _____

1st 24 hrs. after shot 60 B

Gas _____ Cu. Ft.

Dry Hole _____

Abandoned _____

Date

6/14 19120

Pyle

Scout