


Map No. KANSAS Sec. 36 Twp. 15 R. 15^w
 Well No. 15 Steinert Farm _____
Hartman & Blair Company _____

NORTH

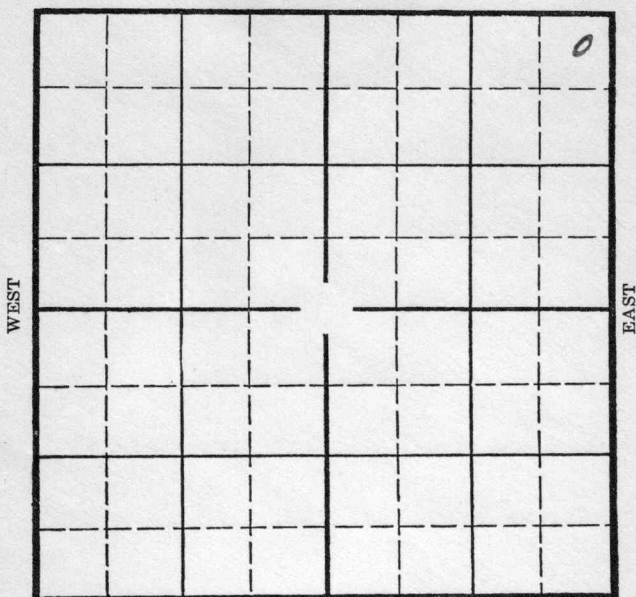

SOUTH

Location _____
 Drilling Remarks _____

Rig Up _____
 Drilling Remarks _____

RECORD

Cased _____ in. _____ ft.
 Sand _____
 Gas _____
 Oil _____
 Total Depth _____

PRODUCTION

1st 24 hrs. Nat. _____
 1st 24 hrs. after shot _____
 Gas _____ cu. ft. _____
 Dry Hole _____
 Abandoned _____


Russell

Map No. Sec. 36 Twp. 15 R. 15W

Well No. 1-Steinert Farm

Hartman & Blair Company

NORTH

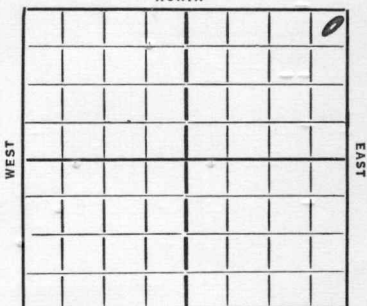

330 Ft. from N. Line

 Ft. from S. Line

330 Ft. from E. Line

 Ft. from W. Line

Elev. 1915

SOUTH

REPORT

1/29	Location
2/7	2/14 - 2/21
2/28	Call
3/6	
3/13	B.R.
3/20	Rig.
3/27	Rign.
4/2	Spud.
4/10	12" @ 429'
4/16	Drlg. 1060'
4/23	Drlg. 1883'
4/30	2257' C.O.
5/7	2357' U.R. 8".
5/14	--
5/21	Drlg. 2555'.
5/28	S.D.
6/4	--
6/11	2555' Drlg. 2555' ---
6/18	Drlg. 2560'.
6/25	Shut down.
7/2	2580'. Drlg.
7/9	Drlg. 2620'.

OVER

Map No. 73 Sec. 36 Twp. 15 R. 15^w

Well No. 1-Steinert

Hartman + Blair Company

Contractor

FIRST REPORTS

SECTION PLAT

330 Ft. from N. Line

..... Ft. from S. Line

330 Ft. from E. Line

..... Ft. from W. Line

			0

Location ✓

Rig up

Drilling and Remarks:

RECORD

Cased.....in.,ft.

Sand.....

Gas.....

Oil.....

Total Depth.....

PRODUCTION

1st 24 hrs. Nat.....

1st 24 hrs. after shot.....

Gas.....Cu. Ft.

Dry Hole.....

Abandoned.....

Date

1-29-36 192.....

ORVAL MANNSCHUECK

Scout

KANSAS

Map No. 73 Sec. 36 Twp. 15 R. 15WWell No. 1 StinsonHarman & Blair Company

Contractor

SECTION PLAT

			0

330 Ft. from N. Line

_____ Ft. from S. Line

330 Ft. from E. Line

_____ Ft. from W. Line

ABANDONED

Location _____

Rig up _____

Drilling and Remarks:

Si 63388NFW 3430IVF

RECORD

Cased _____ in., _____ ft.

Sand _____

Gas _____

Oil _____

Total Depth 3434

PRODUCTION

1st 24 hrs. Nat. _____

1st 24 hrs. after shot _____

Gas _____ Cu. Ft.

Dry Hole _____

Abandoned _____

Date

AUG 26 1936 19S. J. LEWIS Scout

7/16-2700' run 6".
7/23-Topeka 2860'. Drlg.
7/30-Hole full of water 3065-70'. Under
ream 6".
8/6--~~8/13~~
8/13-Kansas City 3146'. Set 6" @ 3146'.
Drlg. 3149'.
8/20-Oswald 3146'. Conglomerate 3325'.
Show oil 3230'.

8/26/36-Sil. 3388'.
Hole full of water 3430'.
T.D. 3434'.
Dry and abandoned.

ABANDONED